

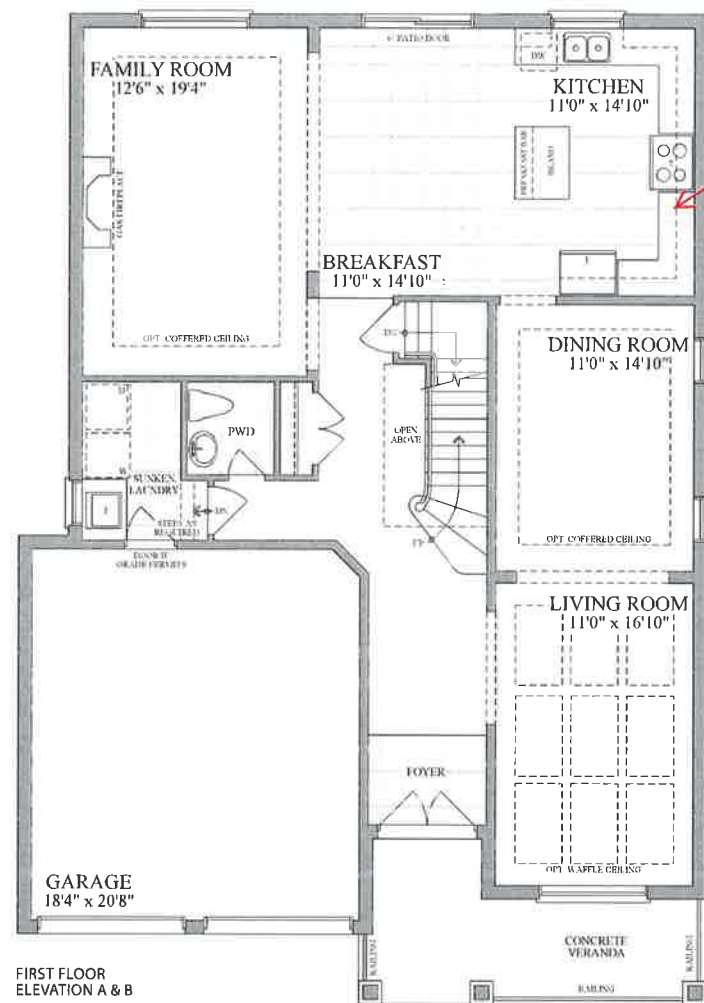


47'
DESIGNS

The **Kahshe** / Elev. A & B
3000 sq.ft.

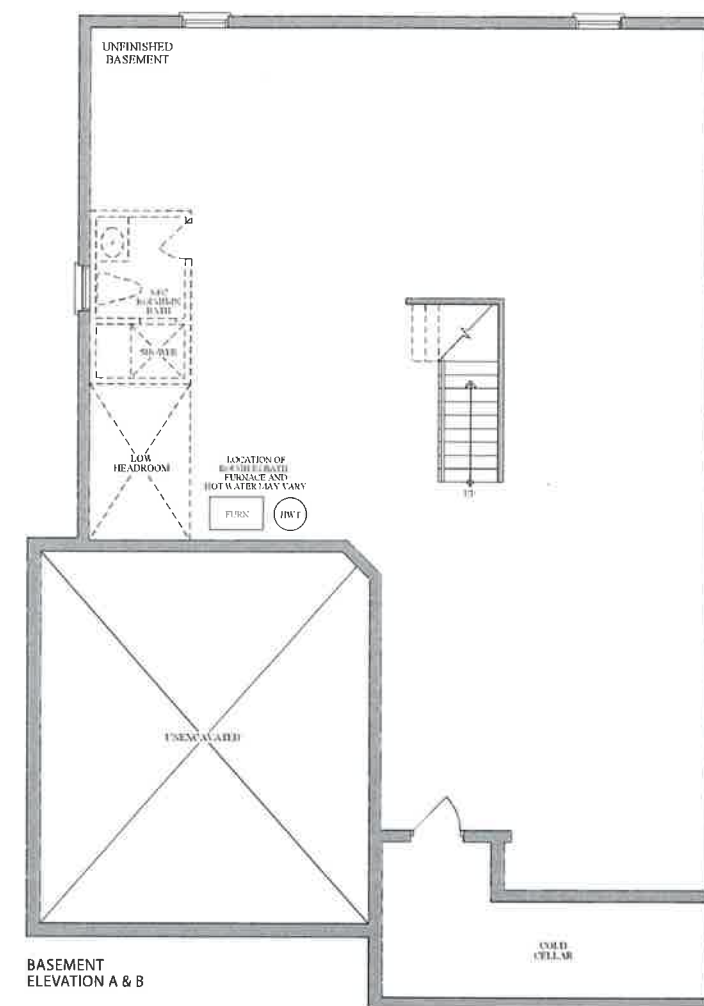

Built-in Microwave

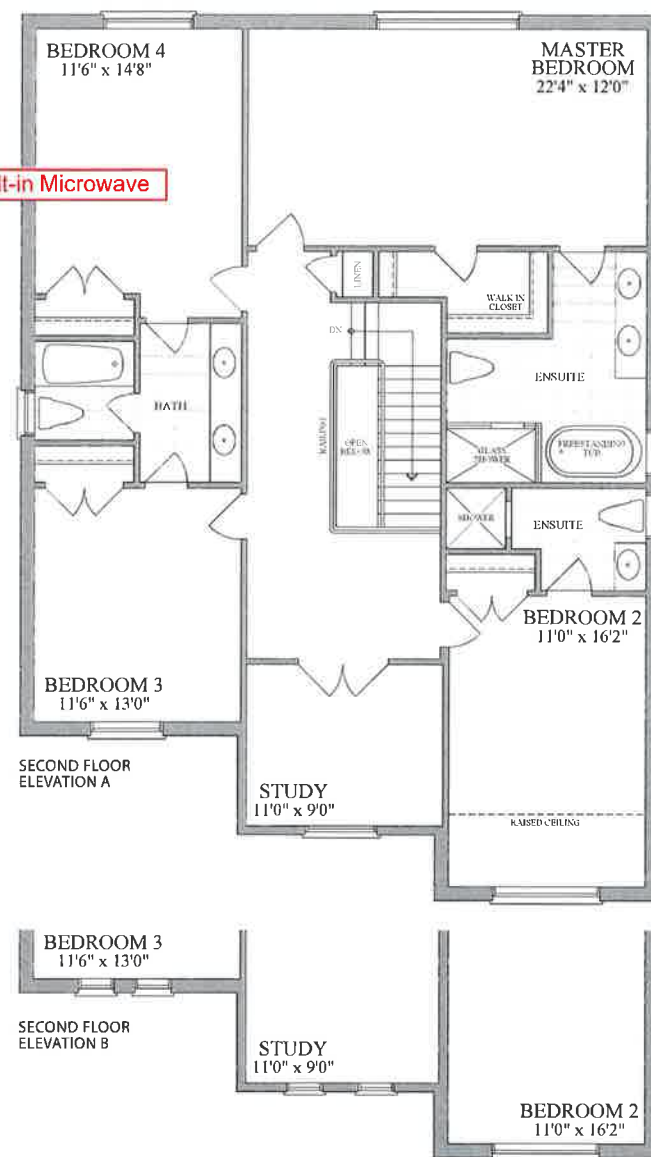

LOT 5-60, PH5, INNISFIL, PE 003

PURCHASER INITIALS:



Plans and specifications are subject to change without notice. E. & O. E. Actual usable floor space may vary from the slated floor area. All renderings are artist's concept.