


LOT 5-73, INNISFIL - PE004

Purchaser's Initial: OK

Standard
Fireplace to be
installed -
centered

38'
The Temagami / Elev. A & B

Includes 760 sq. ft. of finished area in lower level

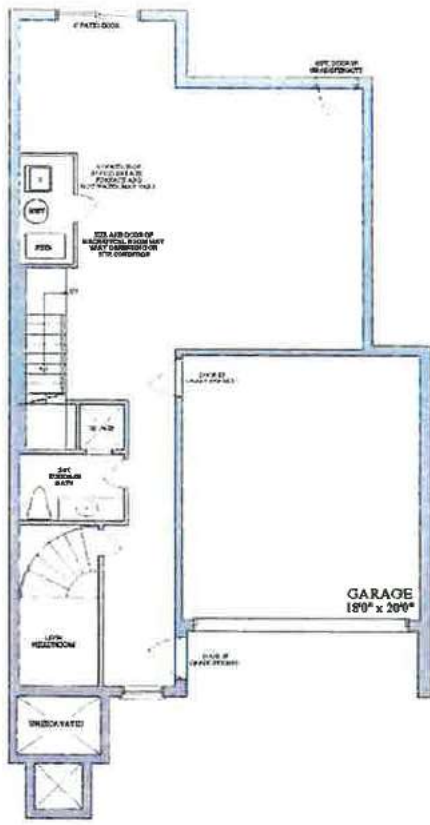

Plans and specifications are subject to change without notice. E, A & B are for informational purposes only and are not to be used for construction. All dimensions are approximate.

LOT 5-73, PE003, SKETCH

Purchaser Onel Khosho (Sep 30, 2021 15:47 EDT)