



LOT # 010 P.E #002 – Model - BUCKHORN - 1800 - PHASE 5


*****Also, it is very important to speak to Roberto Ruiz before starting on site ****

[illegible]


NOTE: If more information is needed please call Roberto Ruiz cell-416-688-9324
If more information needed on quotes or changes, please call Zachary 905-832-2023 ext. 224

38'
DESIGNS


The Buckhorn / Elev. A & B
1800 sq.ft.

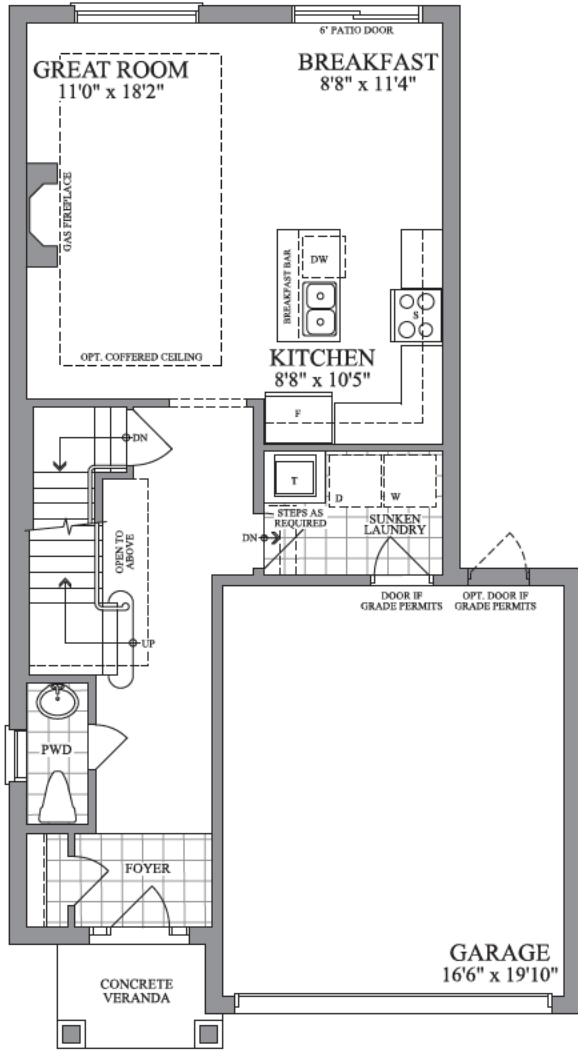


FIRST FLOOR
ELEVATION A & B

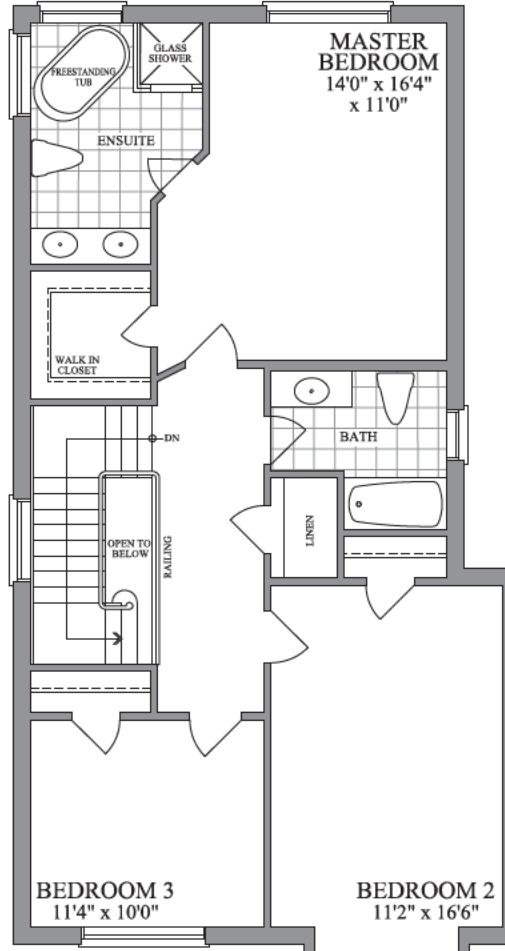

SECOND FLOOR
ELEVATION A

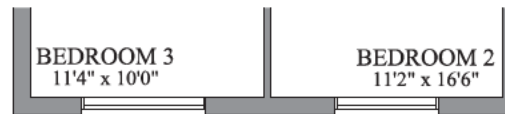

SECOND FLOOR
ELEVATION B

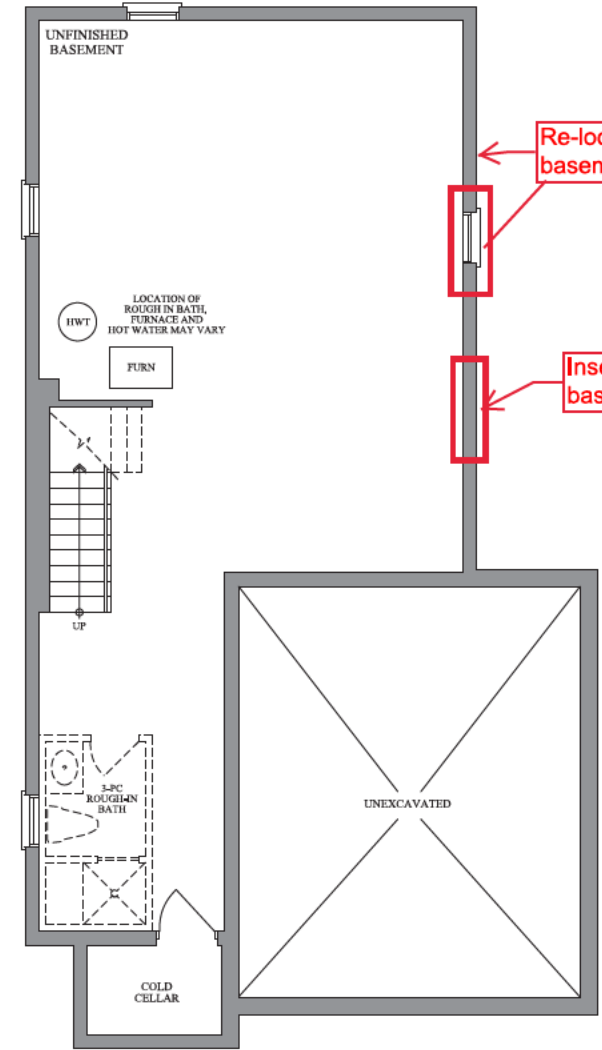

BASEMENT
ELEVATION A & B

Re-locate existing
basement window

Insert additional
basement window



LOT 5-10, PH5, INNISFIL, PE002

PURCHASER: Tony Payyappillil Johny (May 17, 2022 17:14 EDT)

PURCHASER: Smitha Thomas (May 17, 2022 17:17 EDT)




Plans and specifications are subject to change without notice, E. & O. E. Actual usable floor space may vary from the stated floor area. All renderings are artist's concept.

38'
DESIGNS


The Buckhorn / Elev. A & B
1800 Sq.ft.




Plans and specifications are subject to change without notice, E. & O. E. Actual usable floor space may vary from the stated floor area. All renderings are artist's concept.

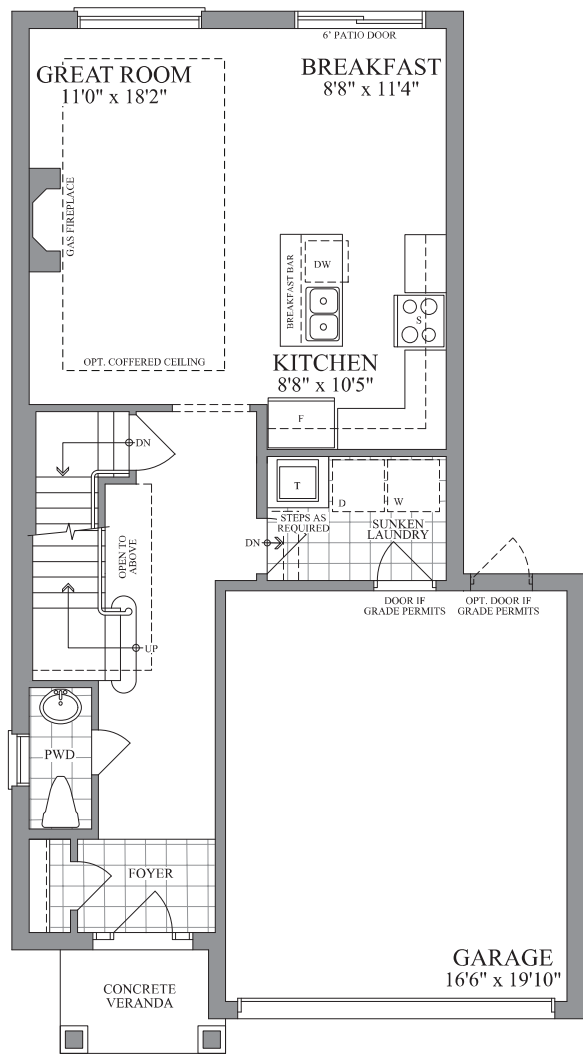


FIRST FLOOR
ELEVATION A & B

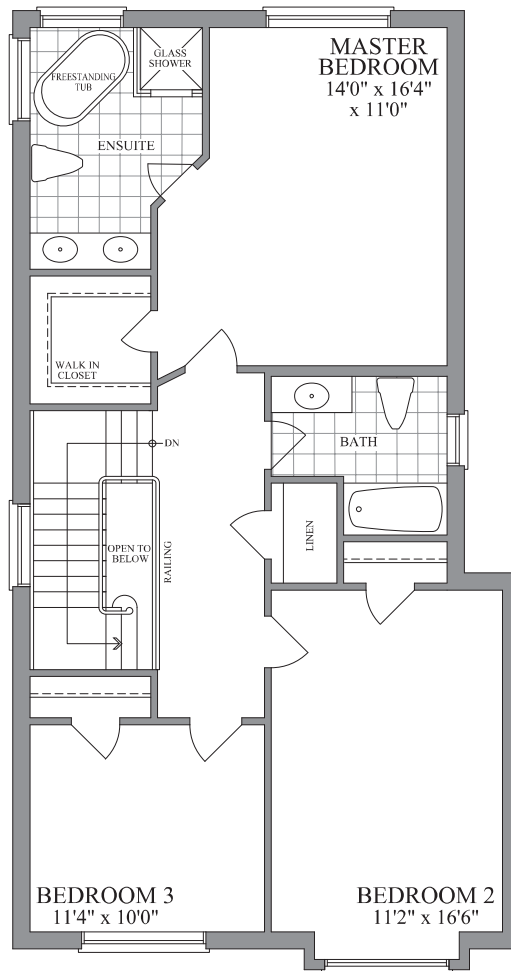

SECOND FLOOR
ELEVATION A

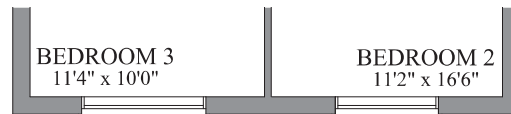


SECOND FLOOR
ELEVATION B

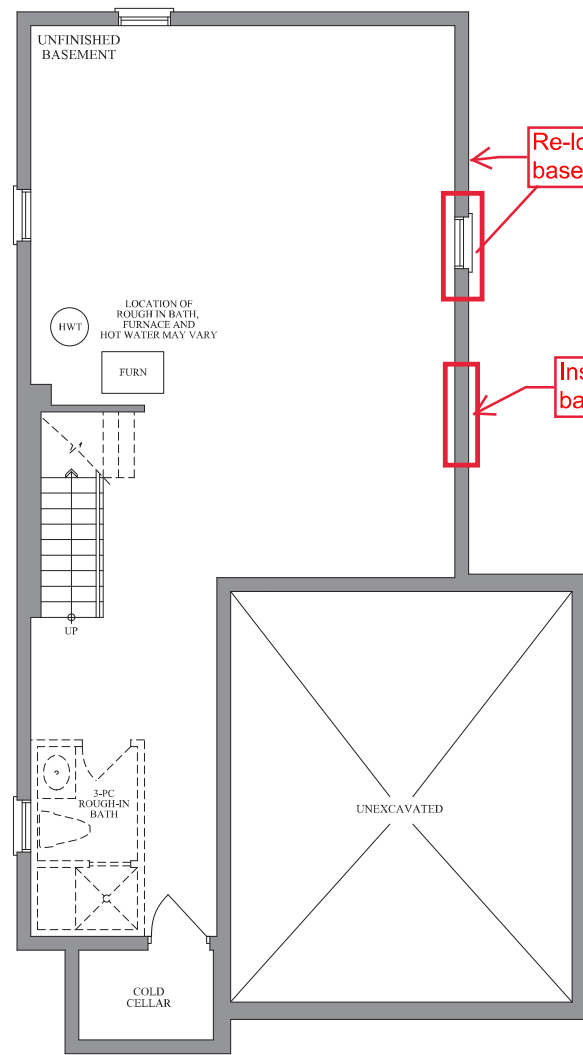

BASEMENT
ELEVATION A & B



LOT 5-10, PH5, INNISFIL, PE002

PURCHASER:  Tony Payyappillil Johny (May 17, 2022 17:14 EDT)

PURCHASER:  Smitha Thomas (May 17, 2022 17:17 EDT)