
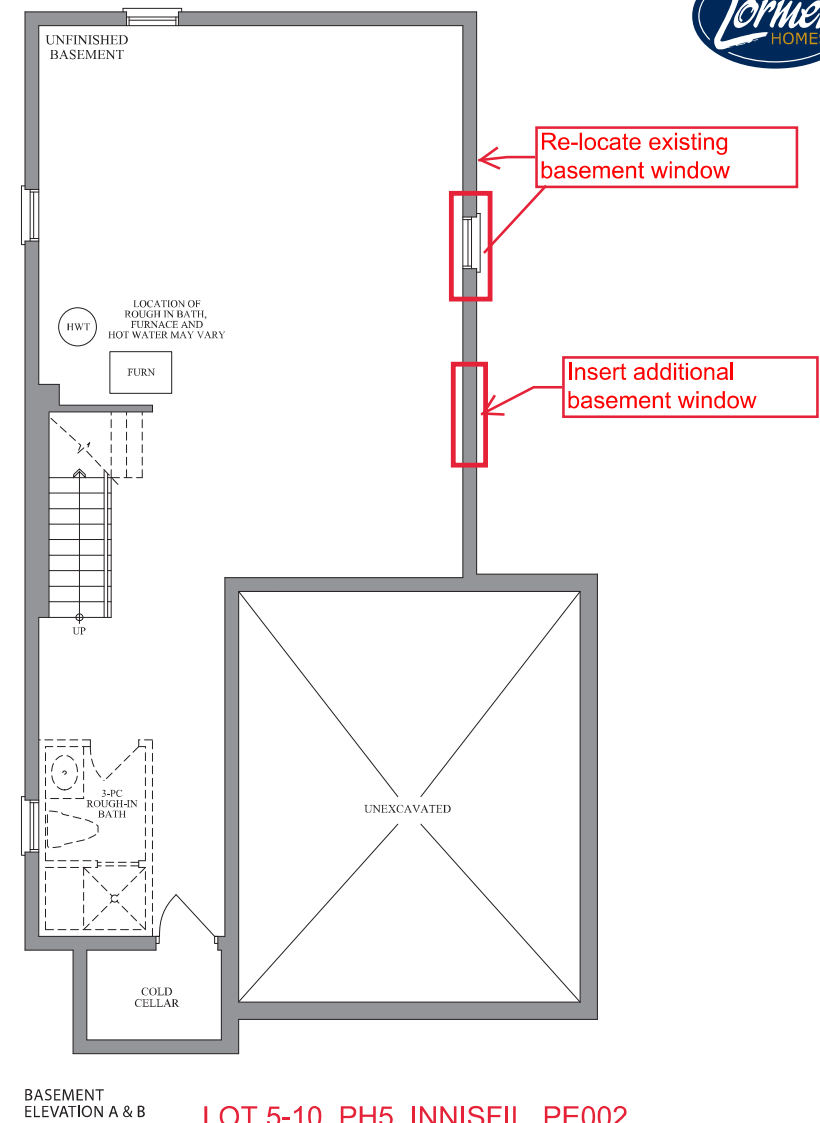
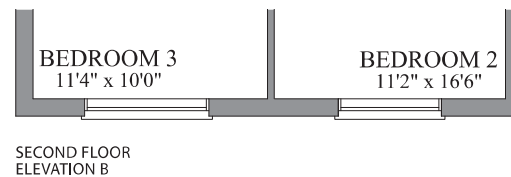
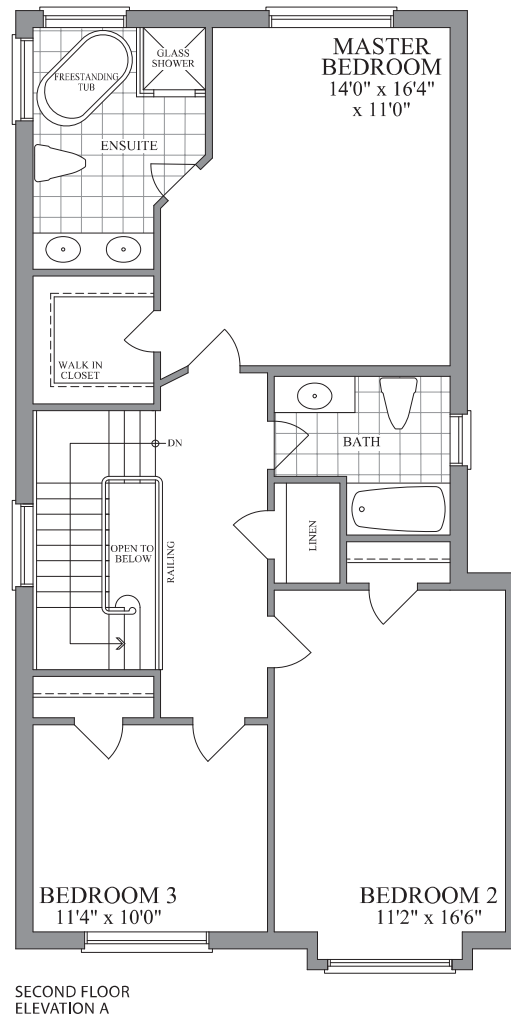


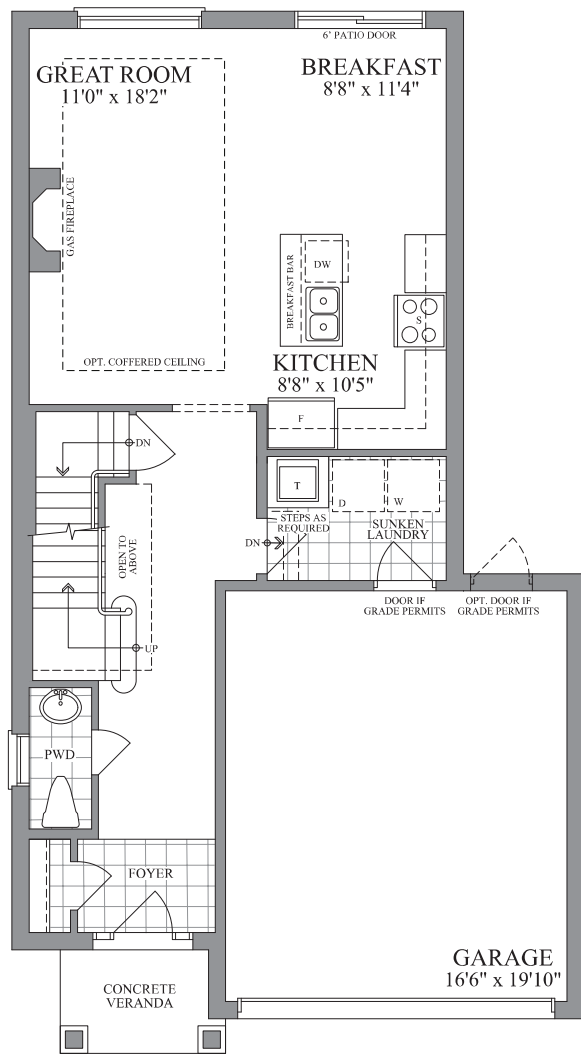

LOT 5-10, PH5, INNISFIL, PE002

PURCHASER:  Tony Payyappillil Johny (May 17, 2022 17:14 EDT)

PURCHASER:  Smitha Thomas (May 17, 2022 17:17 EDT)