
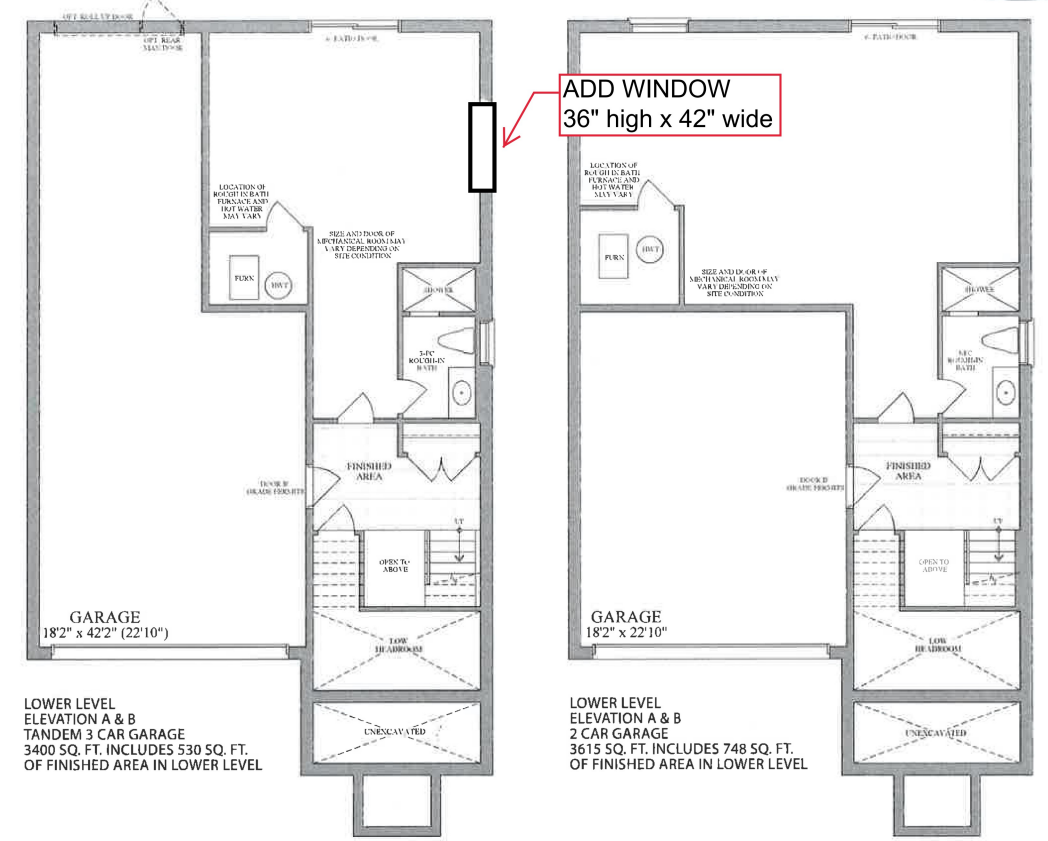


38'
DESIGNS

The Superior / Elev. A & B
3 Car Tandem 3400 sq.ft. - includes 530 sq. ft. of finished area in lower level
2 Car Garage 3615 sq.ft. - includes 748 sq. ft. of finished area in lower level

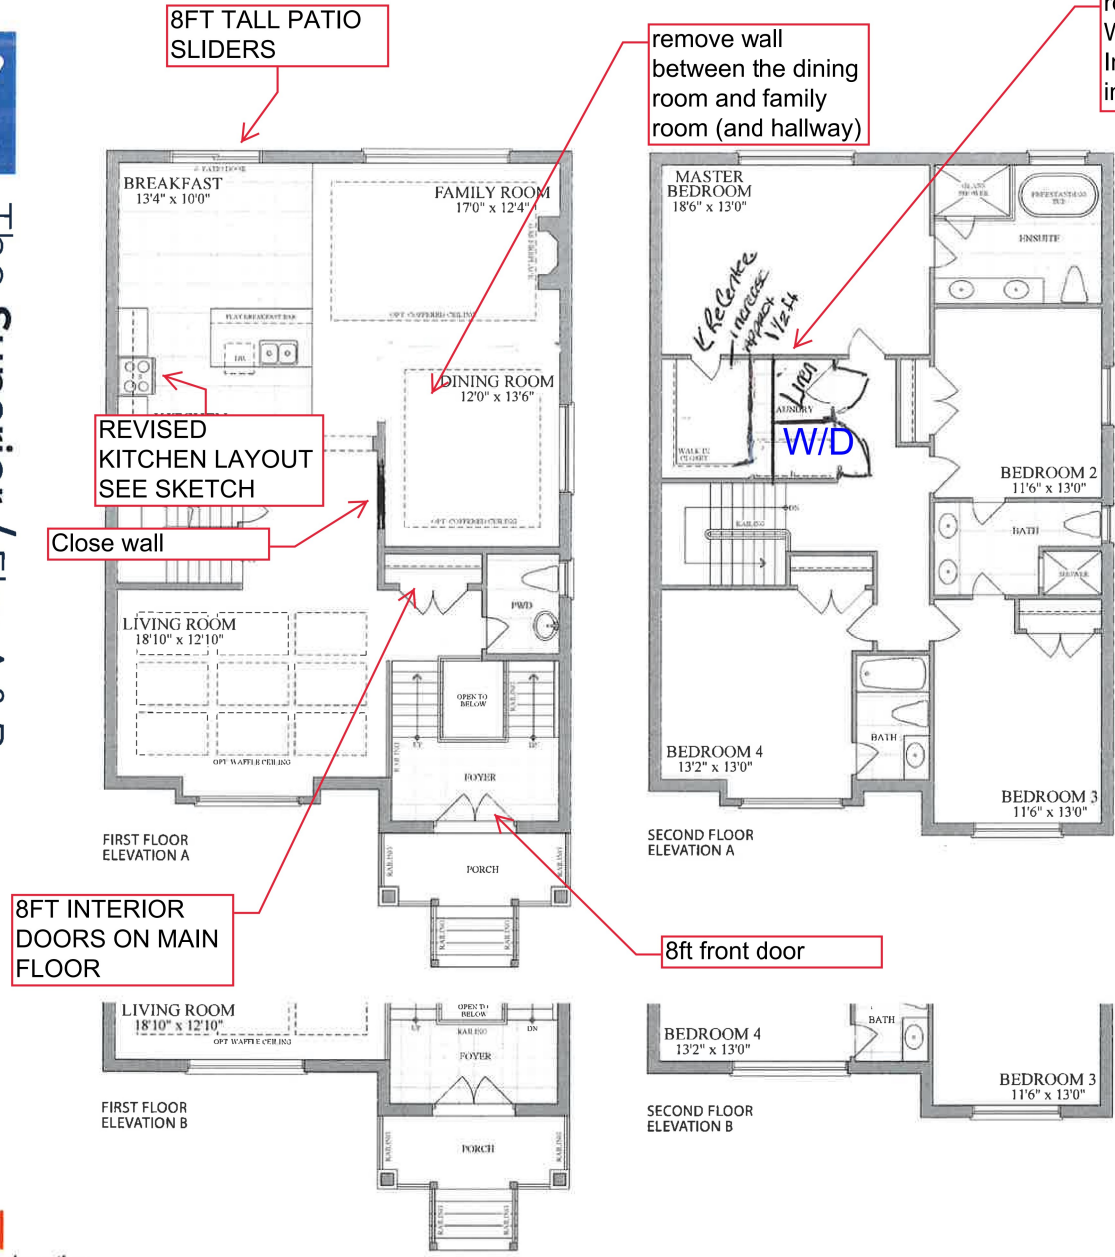


LOT 5-08, PH5, PE003, SKETCH

Purchaser: Habib Zamani (Jun 15, 2022 11:50 EDT)



Plans and specifications are subject to change without notice, E. & O. E. Actual usable floor space may vary from the stated floor area. All renderings are artist's concept.

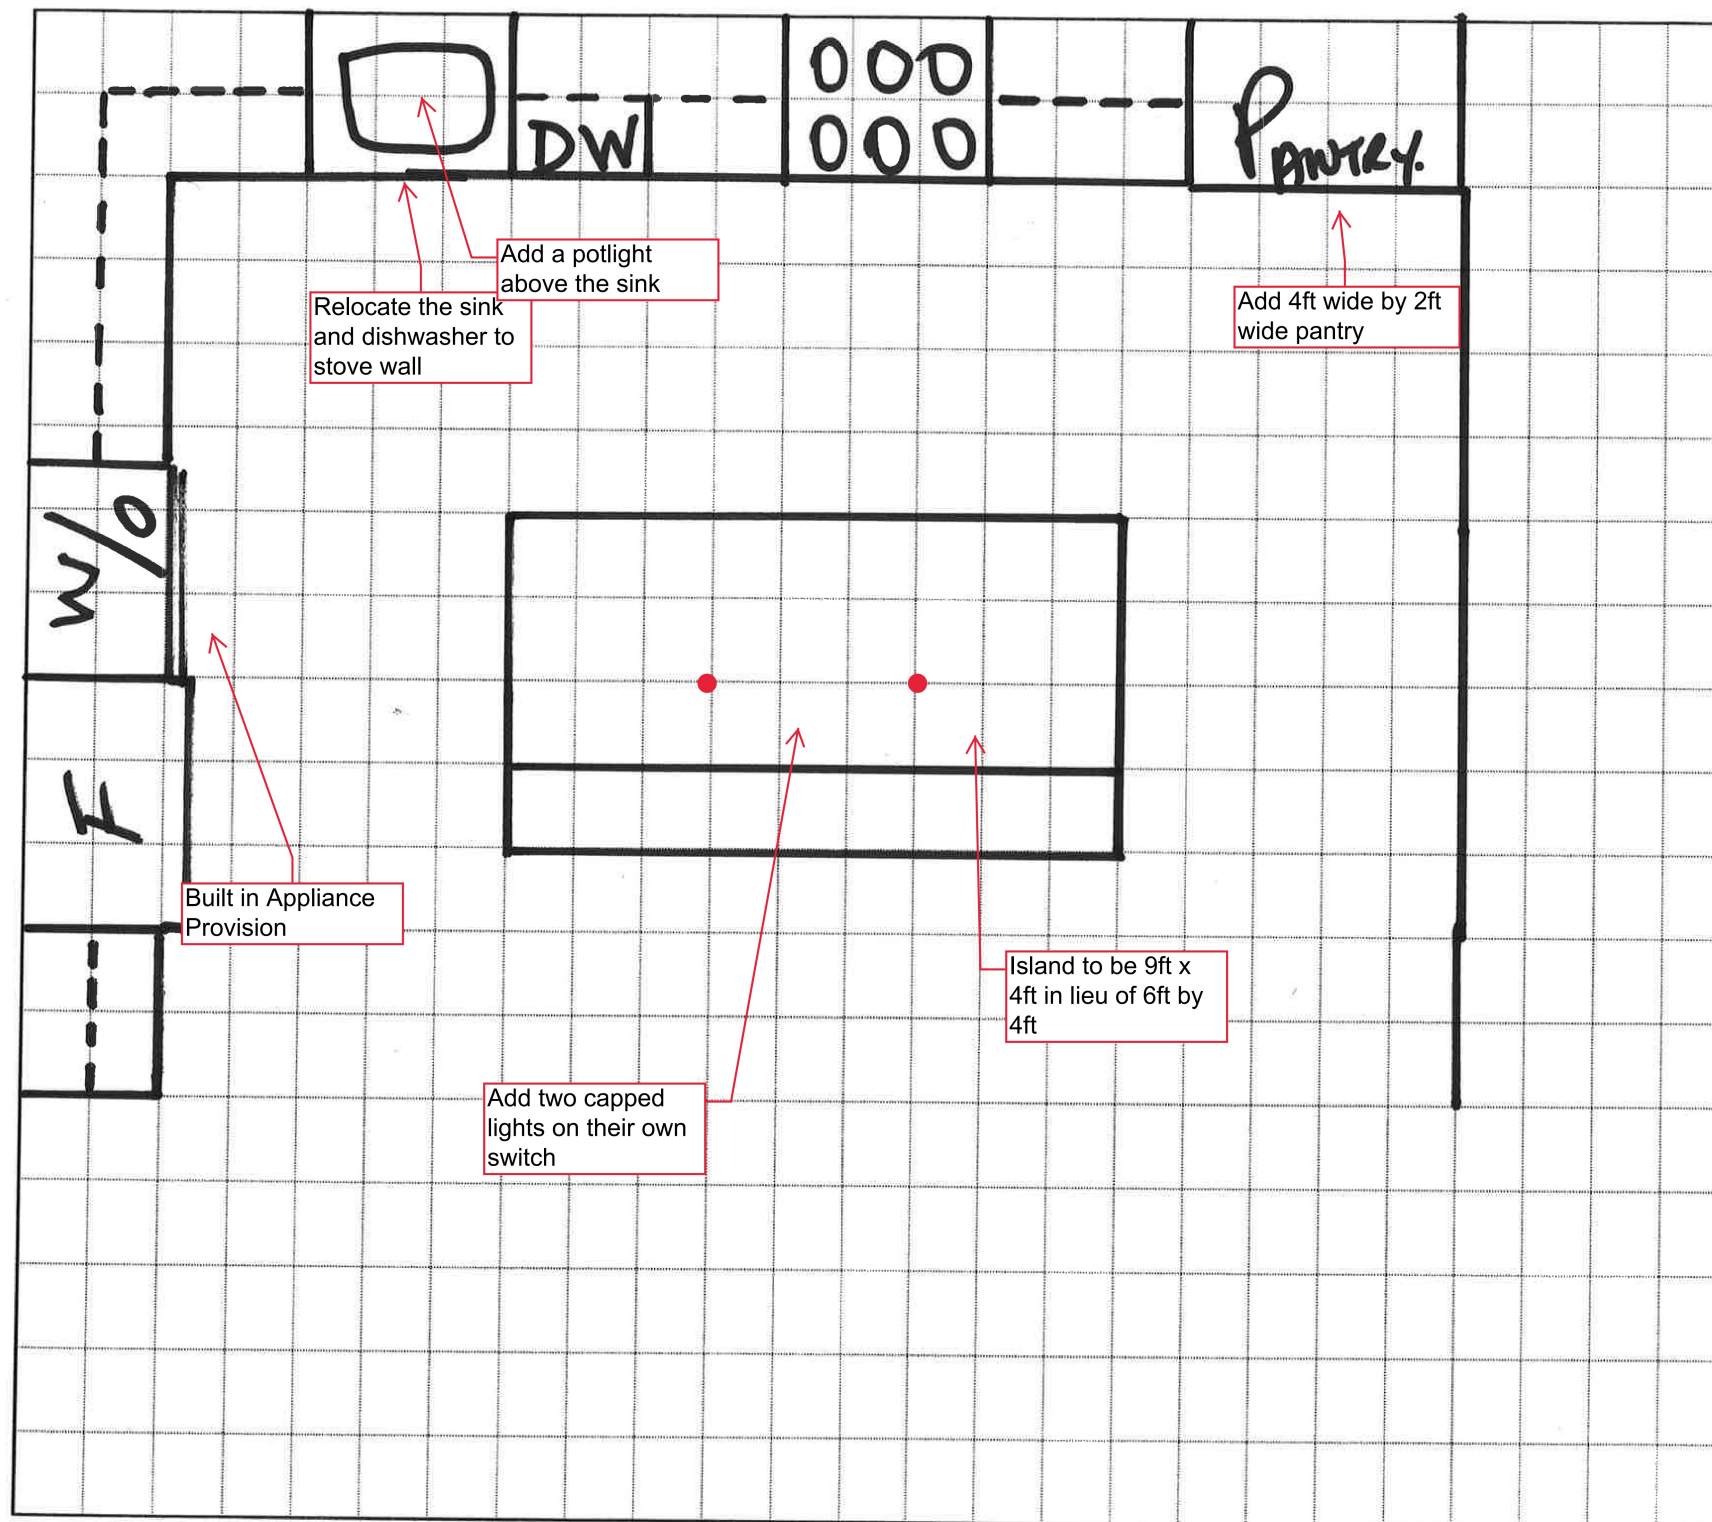

- LOT 5-08, PH5
KITCHEN LAYOUT CHANGE AND
EXTENSION
1. BUILT-IN APPLIANCE PROVISION - Includes Counter Depth Fridge Enclosure; Wall Oven(s) and/or Micro cabinet; 36" cooktop with pot and pan drawer
 2. Relocate the sink and dishwasher from the island to the stove wall. No cabinets above the sink.
 3. Add potlight above the sink
 4. Extend kitchen cabinetry on stove all, approximately 6ft of upper and lowers.
 5. Install a pantry - 4ft wide by 2ft deep
 6. Increase island to 9ft wide by 4ft in lieu of 6x4 - includes the extended flat bar top

● capped ceiling lights above island

Purchaser Habib Zamani (Jun 15, 2022 11:50 EDT)

Purchaser _____