
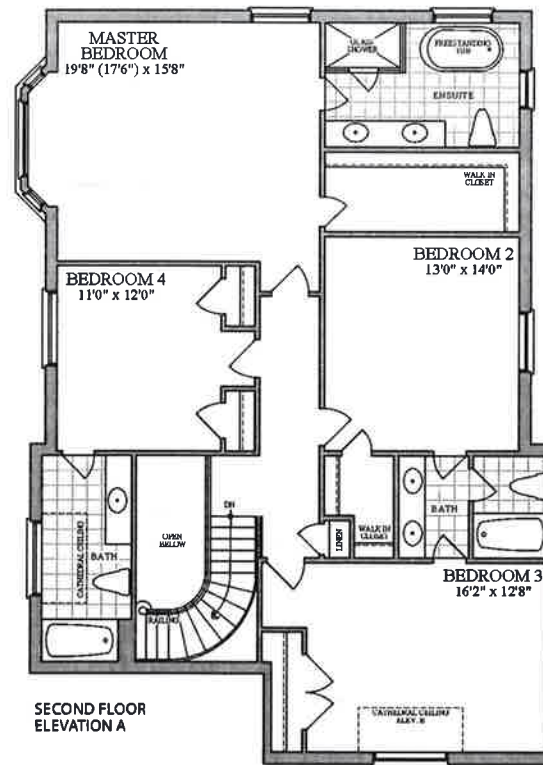
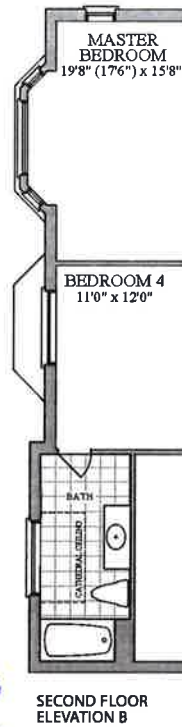
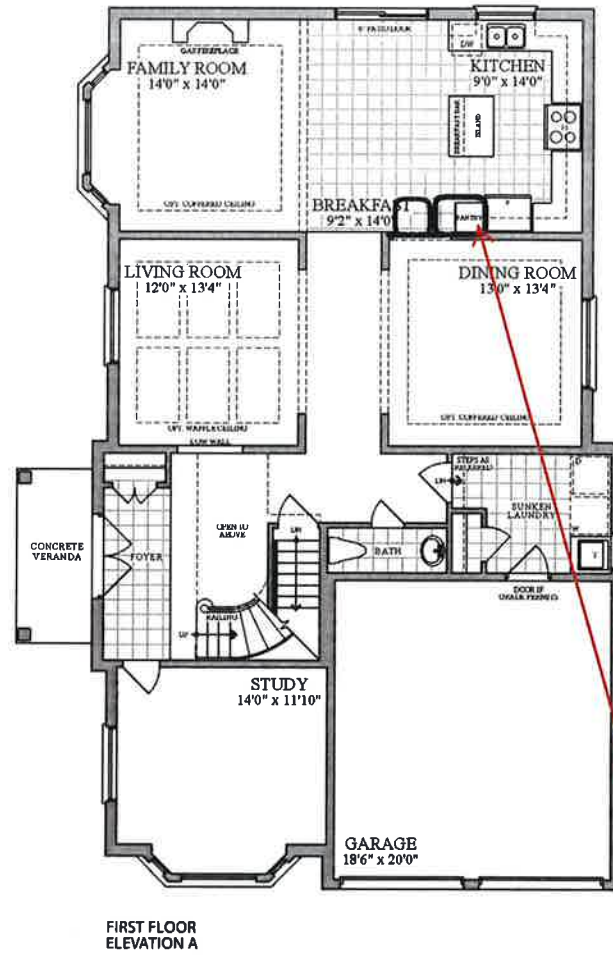


47'
DESIGNS

The madawaska / Elev. A & B
3190 sq.ft.

LOT 5-65, INNISFIL PE 007

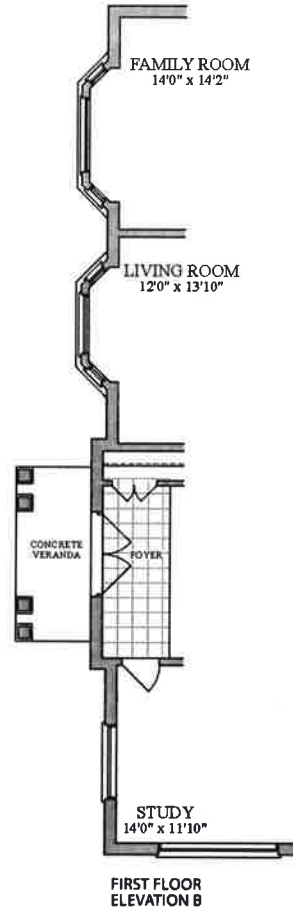

Delete opening from dining room into kitchen area. Shift pantry to the end to accommodate TWO (2) 36" WIDE FRIDGES SIDE BY SIDE

