

LOT 5-68, INNISFIL, PE 007 & PE 008

Purchaser's Initial: MB




47' DESIGNS
The n...
3210 ft.
ng / Elev. A & B

Add one (1) additional CAT 6 plus Electrical outlet in the corner




Conduit for future electric charger

4x5 window
4x5 window
8'1" (High) PATIO DOOR

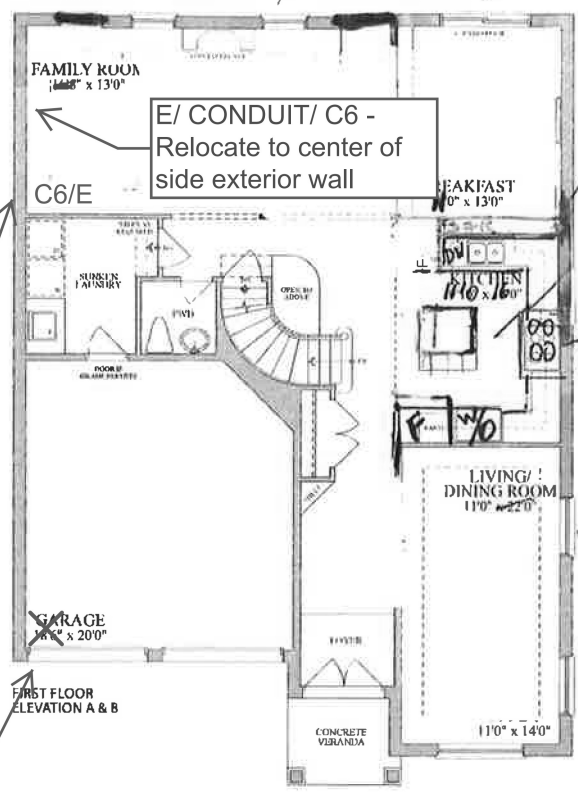

LOT 5-68, CABLE LOCATIONS

Purchaser: MB

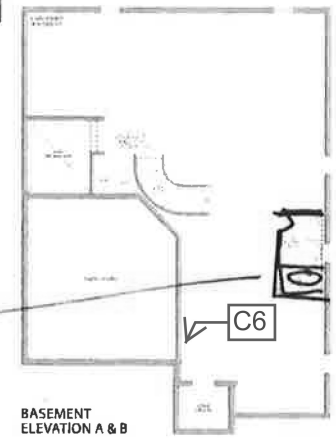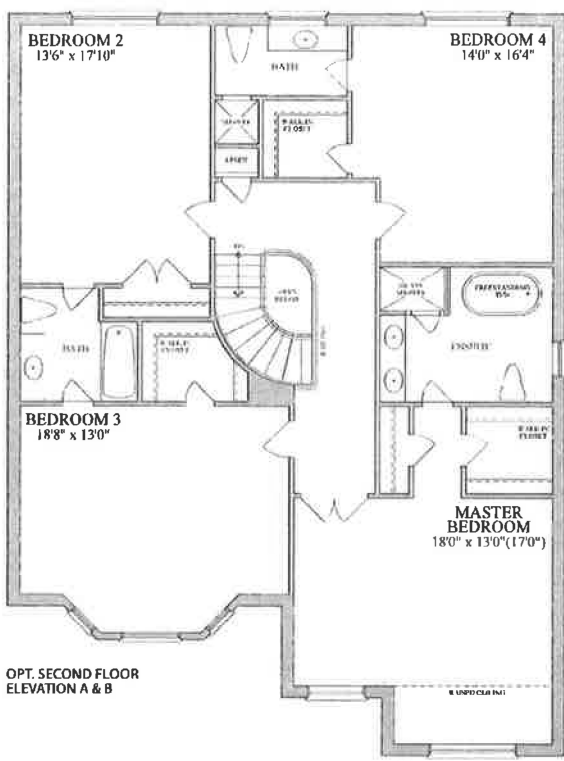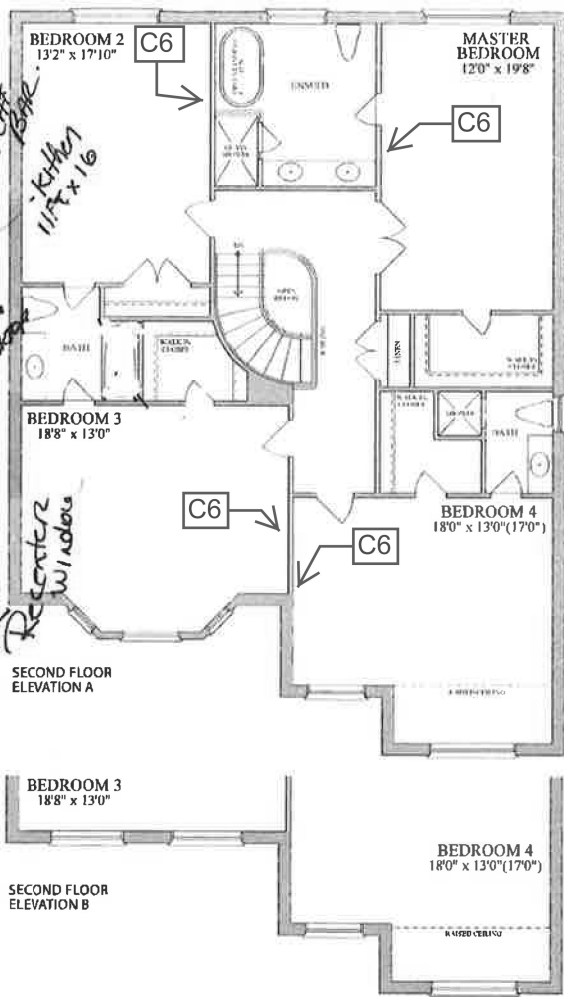

Plans and specifications are subject to change without notice. E, & O E. Actual usable floor space may vary from the stated floor area. All renderings are artist's concept.