







38' DESIGNS

The Temagami / Elev. A & B

3 Car Tandem 3068 sq.ft. - includes 478 sq. ft. of finished area in lower level

2 Car Garage 3350 sq.ft. - includes 760 sq. ft. of finished area in lower level

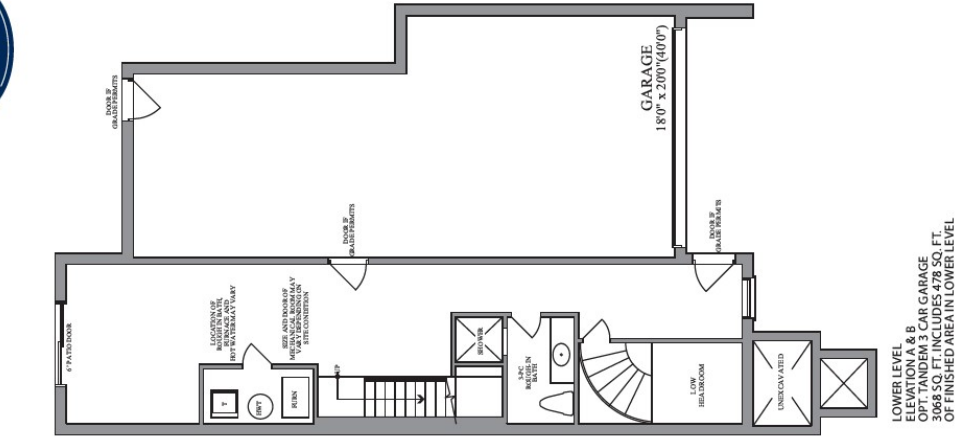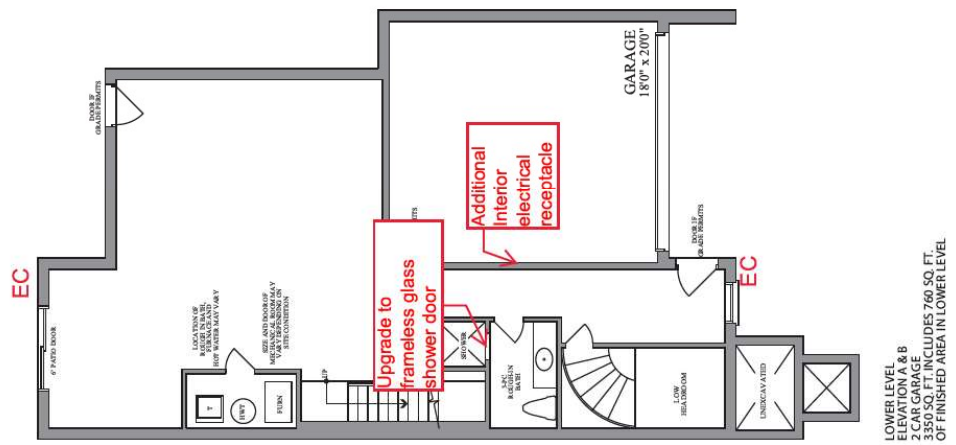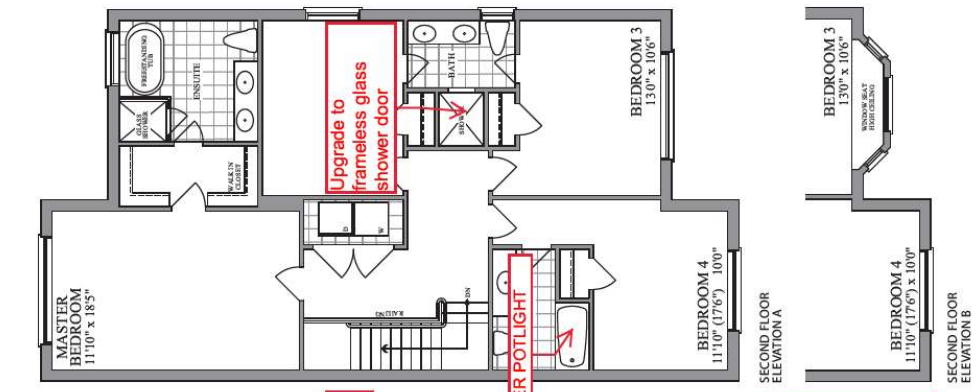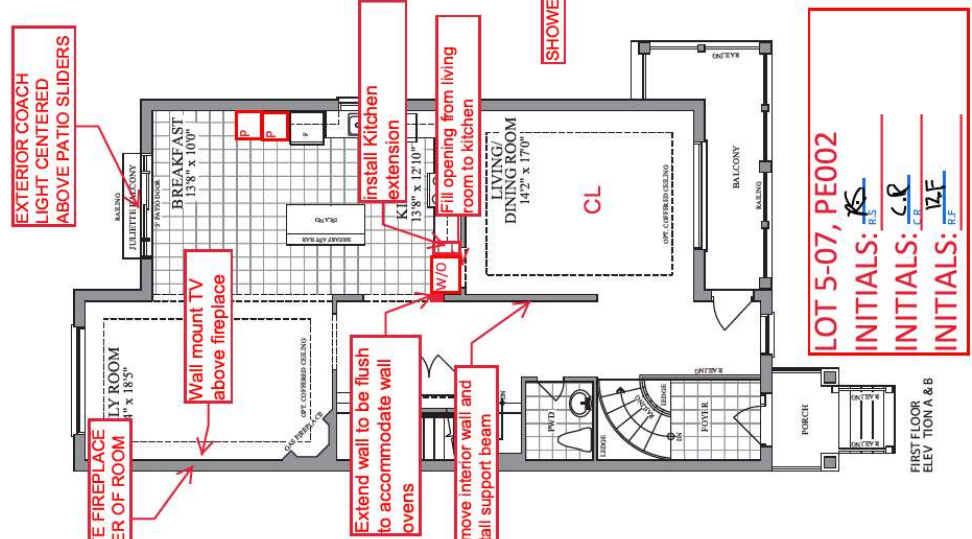

Plans and specifications are subject to change without notice. E. & D. E. Actual cabinet floor space may vary from the stated floor area. All renderings are artist's concept.