

LOT 5-70, PH5, PE00~~X~~ 008

Purchaser's Initial(s): March 24, 2021 SP

Add one (1) electrical receptacle on side of island facing breakfast area

Lot 5-70, PH5, INNISFIL - PE00~~X~~ SKETCH

PURCHASER: Shikha Panchal (Oct 13, 2021 11:05 EDT)

PURCHASER: _____

Delete laundry connections on 2nd floor. *NO TILE ON FLOOR


Rough-in for future wet bar (to be centered along wall)

Add window 6' x 5'


Install complete laundry connections for future washer & dryer - area to remain unfinished

38' DESIGNS

The Temagami / Elev A & B
3 Car Tandem 3068 sq. ft. - includes 478 sq. ft. of finished area in lower level
2 Car Garage 3350 sq. ft. - includes 760 sq. ft. of finished area in lower level

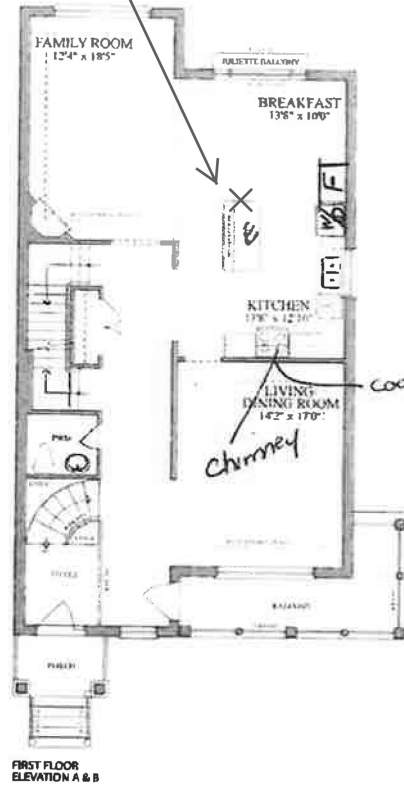


FIRST FLOOR ELEVATION A & B

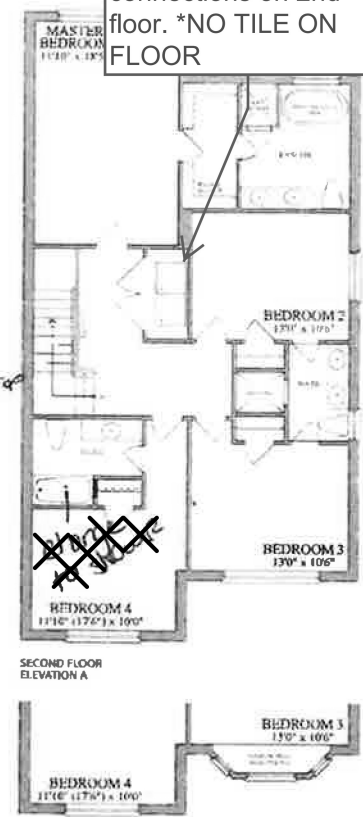


SECOND FLOOR ELEVATION A

SECOND FLOOR ELEVATION B

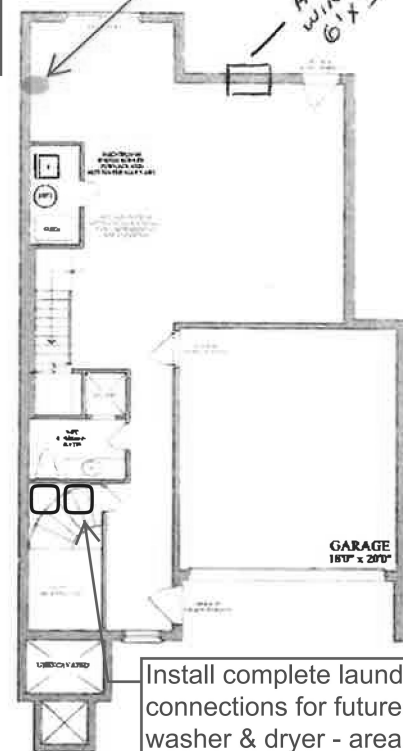

LOWER LEVEL ELEVATION A & B
2 CAR GARAGE
3350 SQ. FT. INCLUDES 760 SQ. FT. OF FINISHED AREA IN LOWER LEVEL

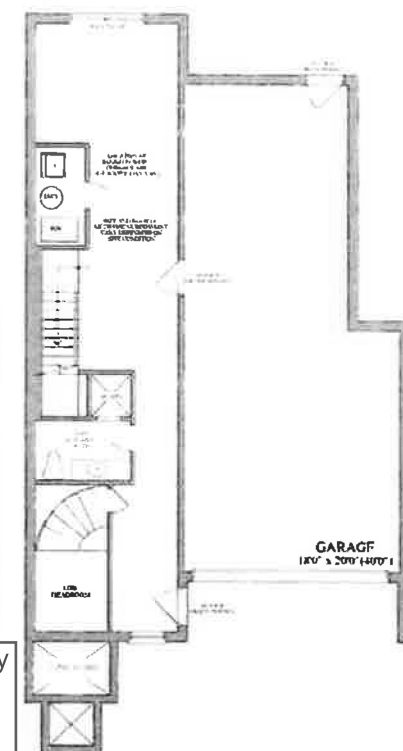

LOWER LEVEL ELEVATION A & B
OPT. TANDEM 3 CAR GARAGE
3068 SQ. FT. INCLUDES 478 SQ. FT. OF FINISHED AREA IN LOWER LEVEL



Plans are preliminary. All features are subject to change without notice. 1:40 & 1:40 scale. All areas are approximate. All dimensions are approximate. All measurements are approximate.

Purchaser's Initial(s): MP SP