


□ = the 2 original pot light from family room to be relocated to the living room

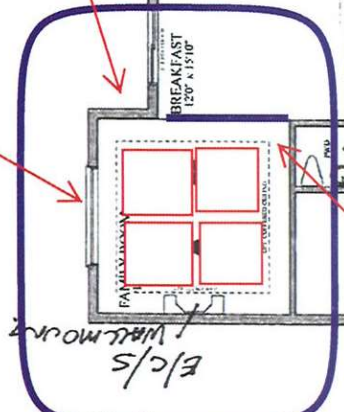

WAFLE CEILING WITH CROWN MOULDING IN FAMILY ROOM - 4 BOXES

Install 1 pot light in each box




Blue Line - Is the header that will run across this opening

INSTALL TWO POT LIGHTS - relocated from family room

Relocate these pot lights to the corners.

Lot 5-6b, PE#005

47' DESIGNS The Carlyle / Elev. A & B 2950 sq.ft.

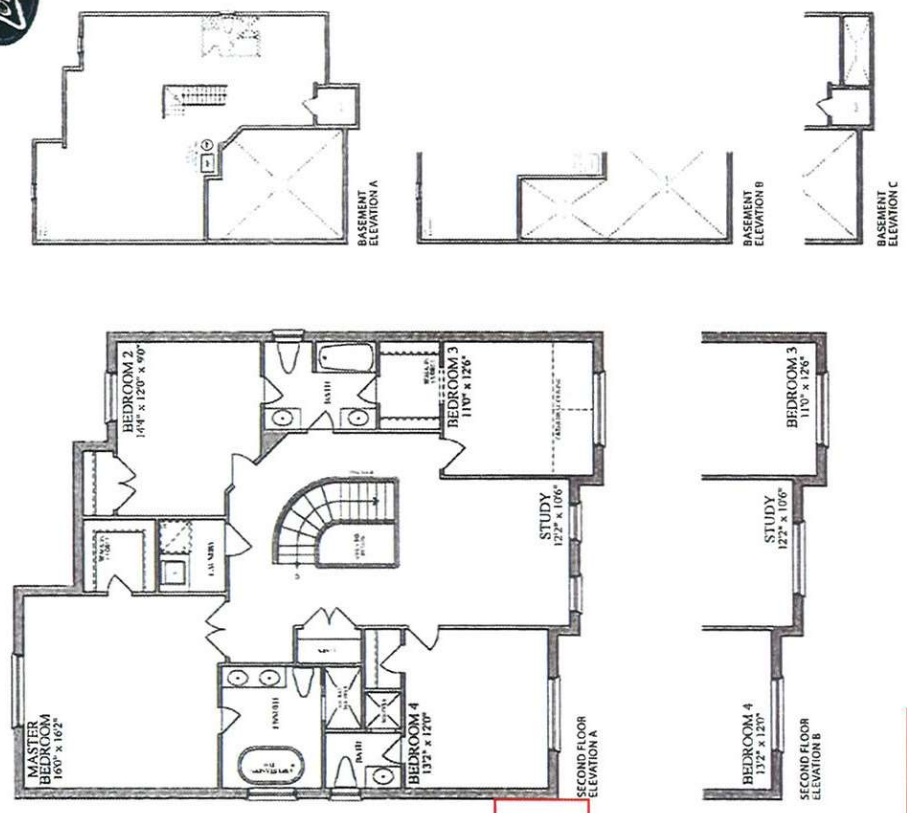

Purchaser's Initial(s): O.A.

Plans and specifications are subject to change without notice. All measurements are in inches unless otherwise noted.