



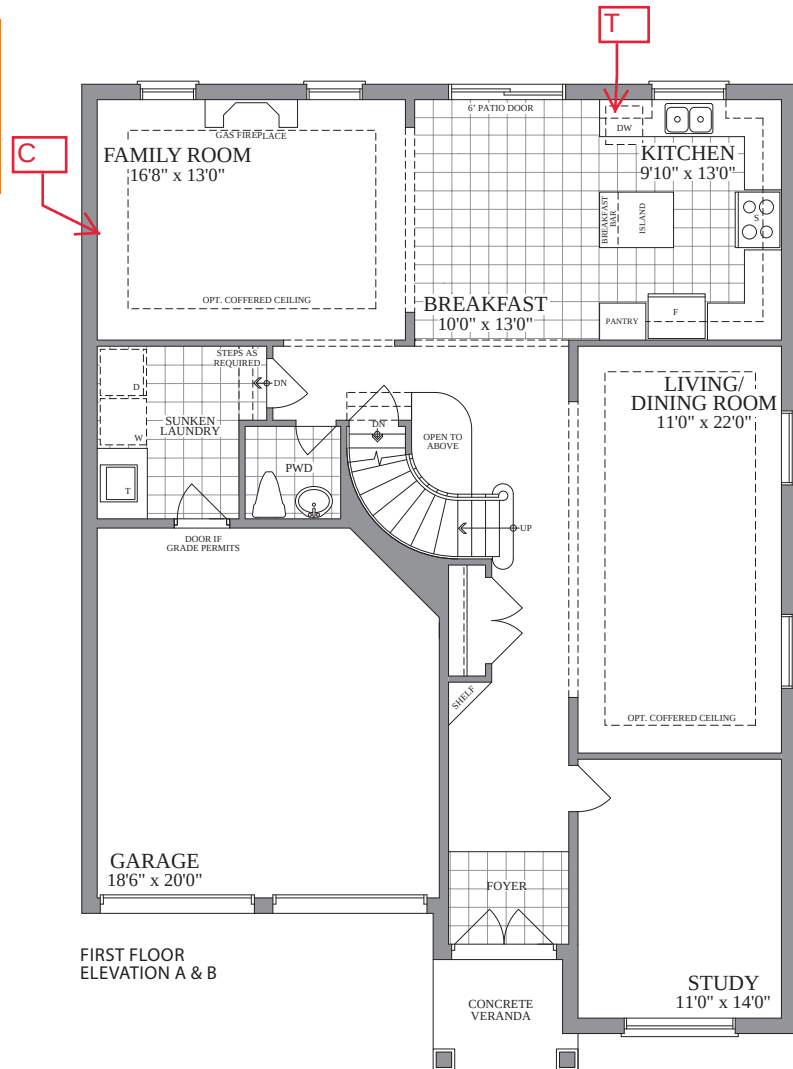


FIRST FLOOR
ELEVATION A & B

Please indicate the location of the rough-ins on your plan


Description	Symbol on Sketch	Standard Locations
Cable (Rough-in)	C	Family room Or Great Room, all bedrooms, Study/Den/Computer, (as per model)
Cat5	CS	A Cat5 wire can replace the rough-in cable at no additional cost.
Cat6	C6	Upgrade - \$50 per location
Telephone (Rough-in)	T	Kitchen and Primary Ensuite
Smart-Wire (Cat5)	S	Can be installed a Purchaser's desired location

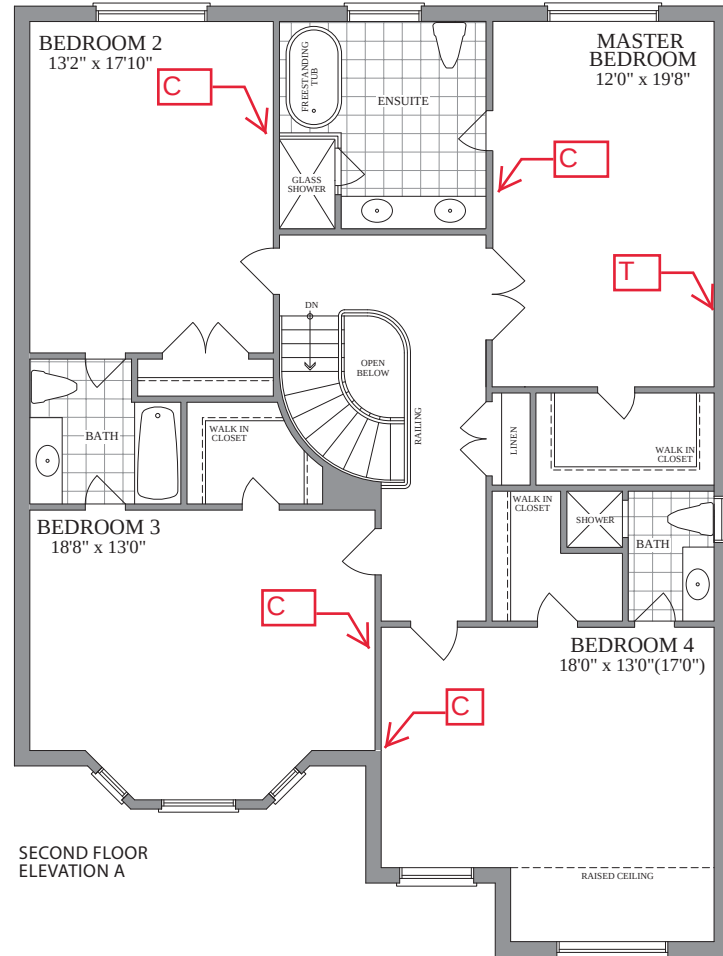

SECOND FLOOR
ELEVATION A

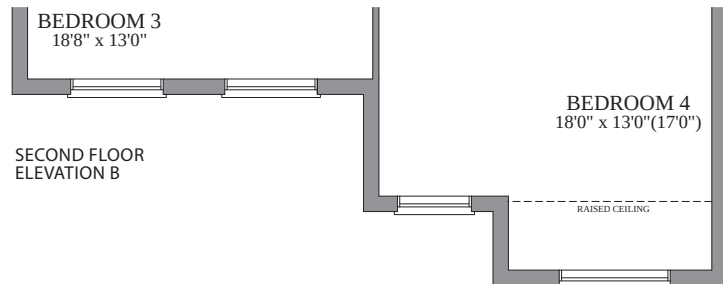


SECOND FLOOR
ELEVATION B

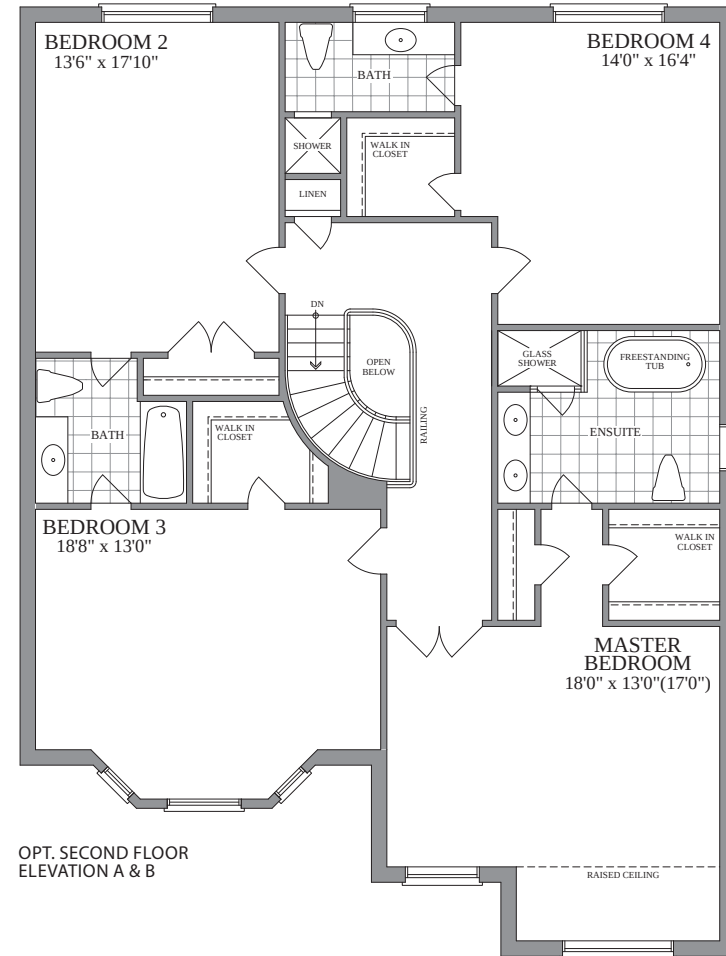

OPT. SECOND FLOOR
ELEVATION A & B

LOT # **LOT 5-83**
PURCHASER: Richie
PURCAHSER: Bill Vu

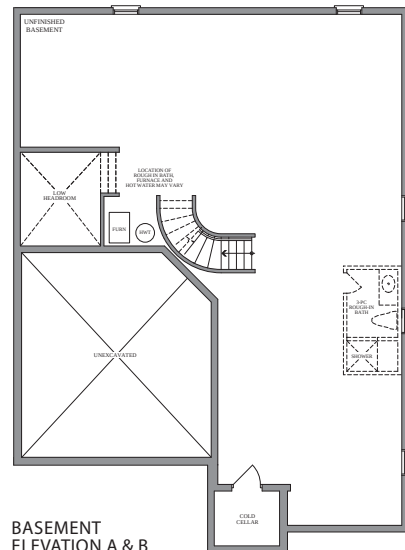

BASEMENT
ELEVATION A & B