



LOT # 070 P.E #009 – Model - TEMAGAMI 2 CAR - 3350 - PHASE 5

The following items below are Purchaser Extras, please make sure that they are done on time and properly complete. Any outstanding items will be Back Charged. If you have any questions please call Roberto Ruiz. Make sure that you review ALL of the items on the Purchaser Extras.

*****Also, it is very important to speak to Roberto Ruiz before starting on site ****

[illegible]

NOTE: If more information is needed please call Roberto Ruiz cell-416-688-9324
If more information needed on quotes or changes, please call Zachary 905-832-2023 ext. 224





the trails at
CARSON'S CREEK

BELLARE PROPERTIES INC.

Detached - Additional PE Form - 04/30/15

38'
DESIGNS

The Temagami / Elev. A & B
3 Car Tandem 3068 sq.ft. - includes 478 sq. ft. of finished area in lower level
2 Car Garage 3250 sq. ft.

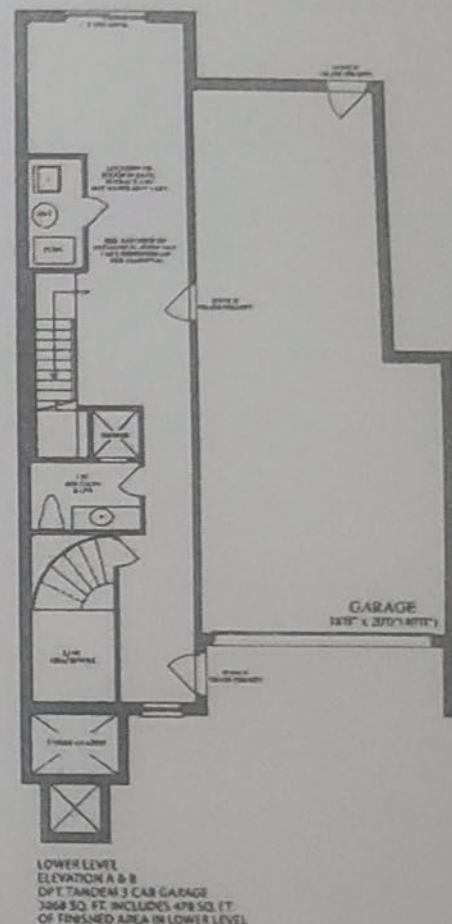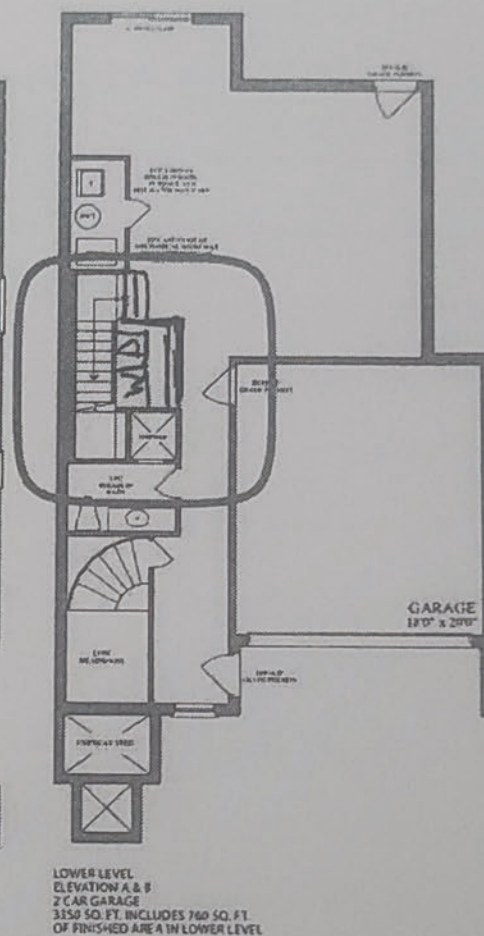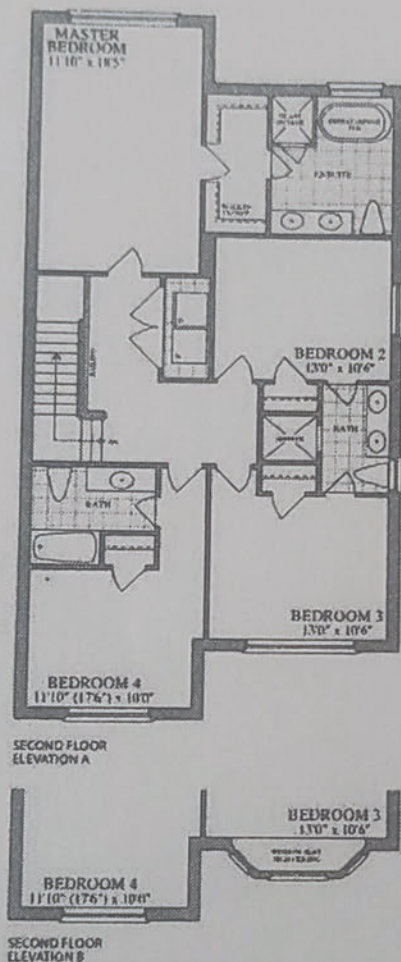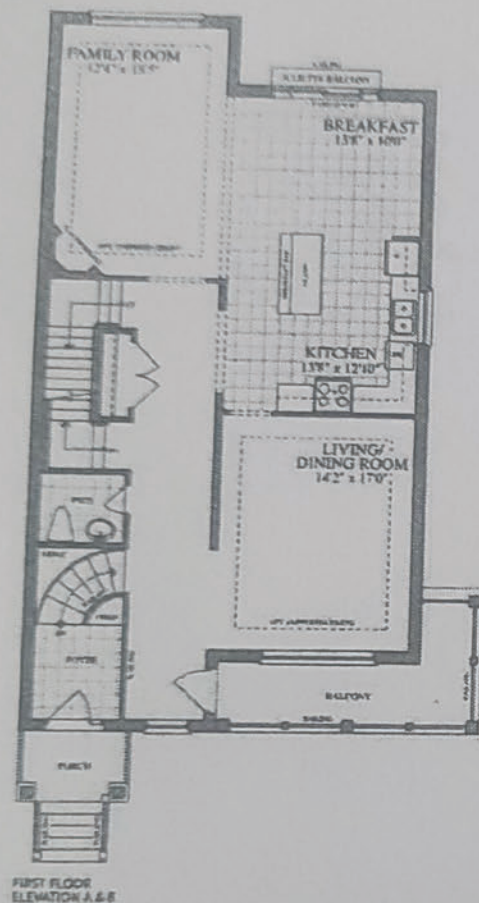

the trails at
ARSON'S CREEK

Plans and specifications are subject to change without notice. E. & S. B. Federal planning board. Plans may vary from the printed floor plan. All measurements are subject to change.

LOT 5-70, PH5, LAUNDRY ROOM - PE009





PURCHASER:

PURCHASER:

Shilke
Mrs

38'
Designs

The Temagami / Elev. A & B
3 Car Tandem 3068 sq.ft. - includes 478 sq. ft. of finished area in lower level
2 Car Garage 3250 sq. ft.

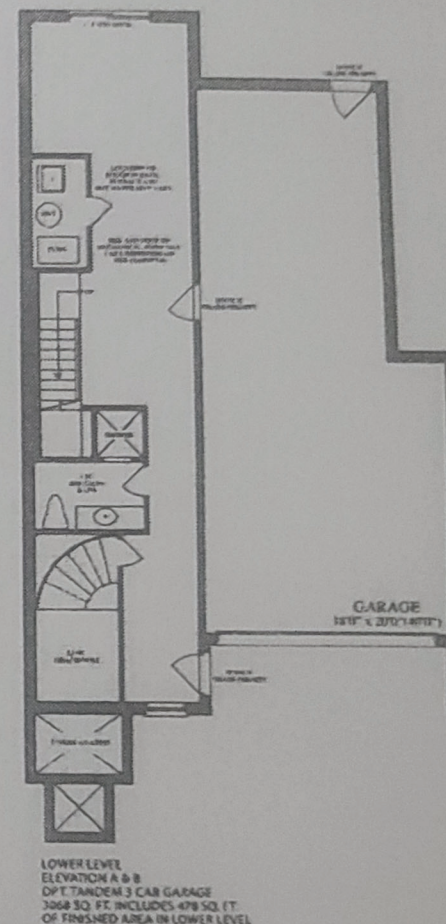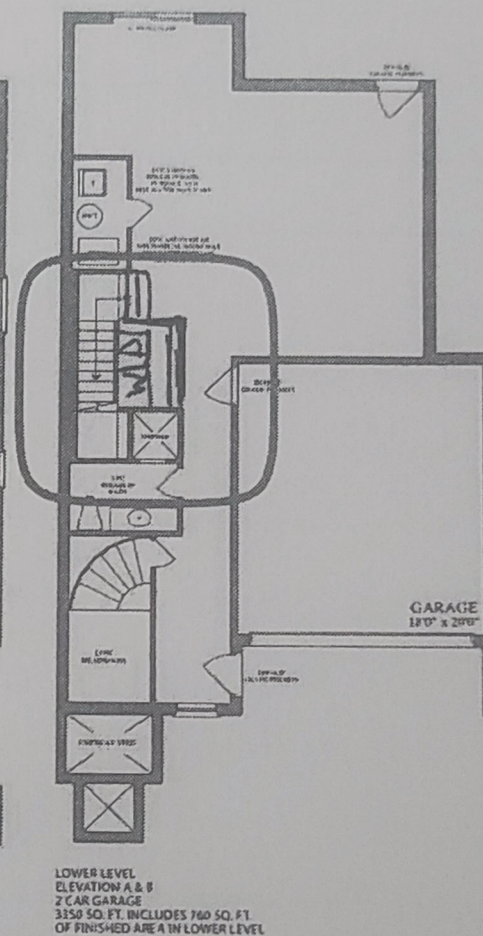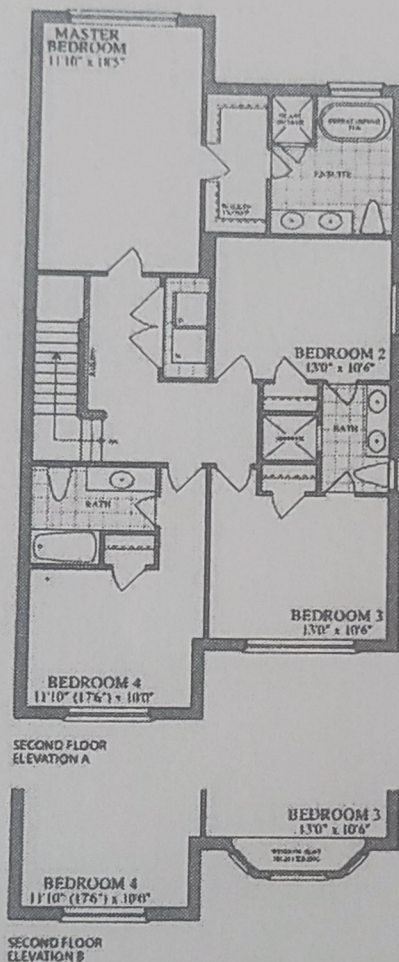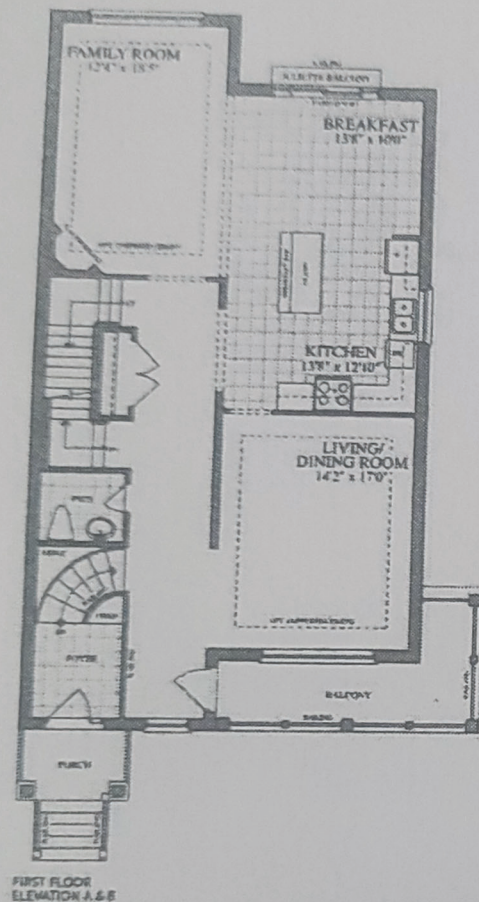

the trade at
ARSON'S CREEK

Plans and specifications are subject to change without notice. E. & S. © 2004 Loribel. All rights reserved. All dimensions are subject to change.

LOT 5-70, PH5, LAUNDRY ROOM - PE009

PURCHASER: Shikha

PURCHASER: Mrs