






FIRST FLOOR
ELEVATION A & B

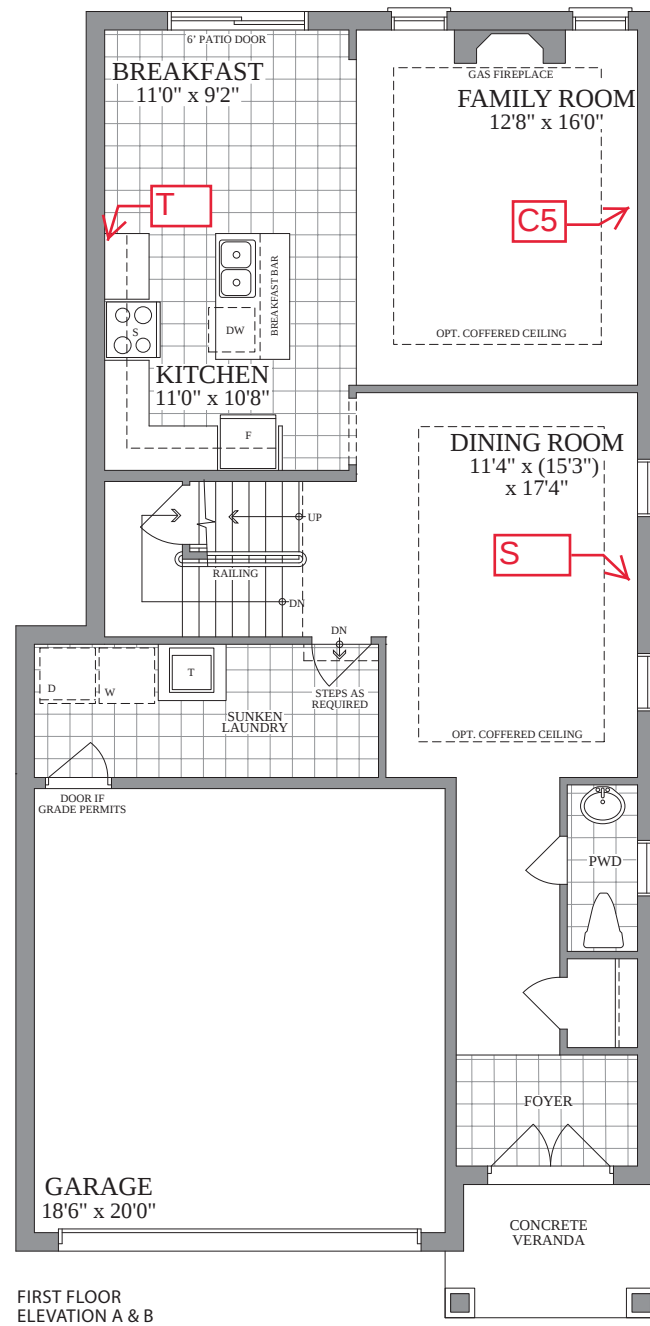

SECOND FLOOR
ELEVATION A

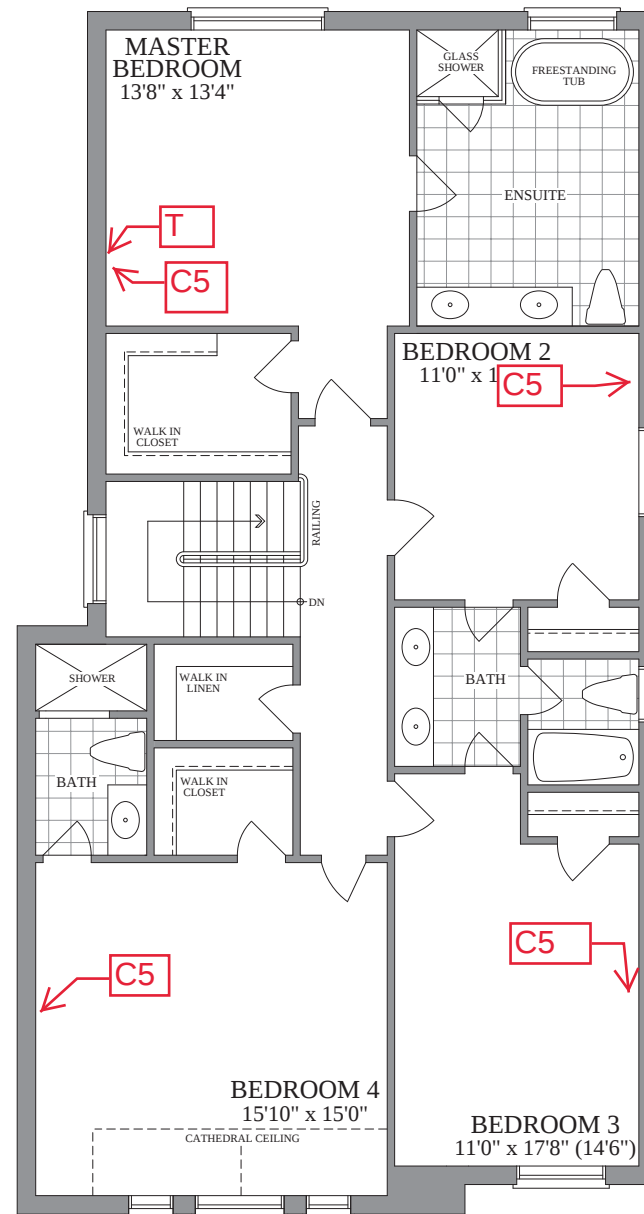

SECOND FLOOR
ELEVATION B

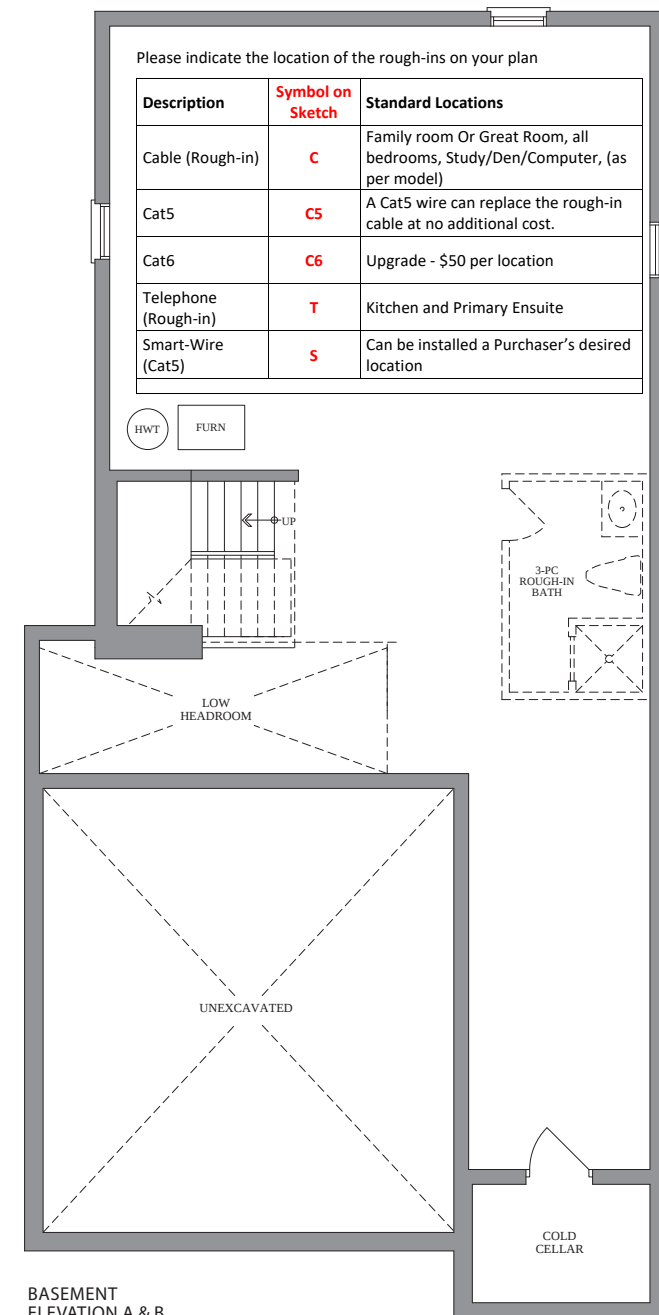

BASEMENT
ELEVATION A & B

LOT #: LOT 5-39

PURCHASER: Qamar Qamar (Aug 16, 2022 15:08 EDT)

PURCHASER:_____