




The Timiskaming / Elev. A
2775 sq.ft.

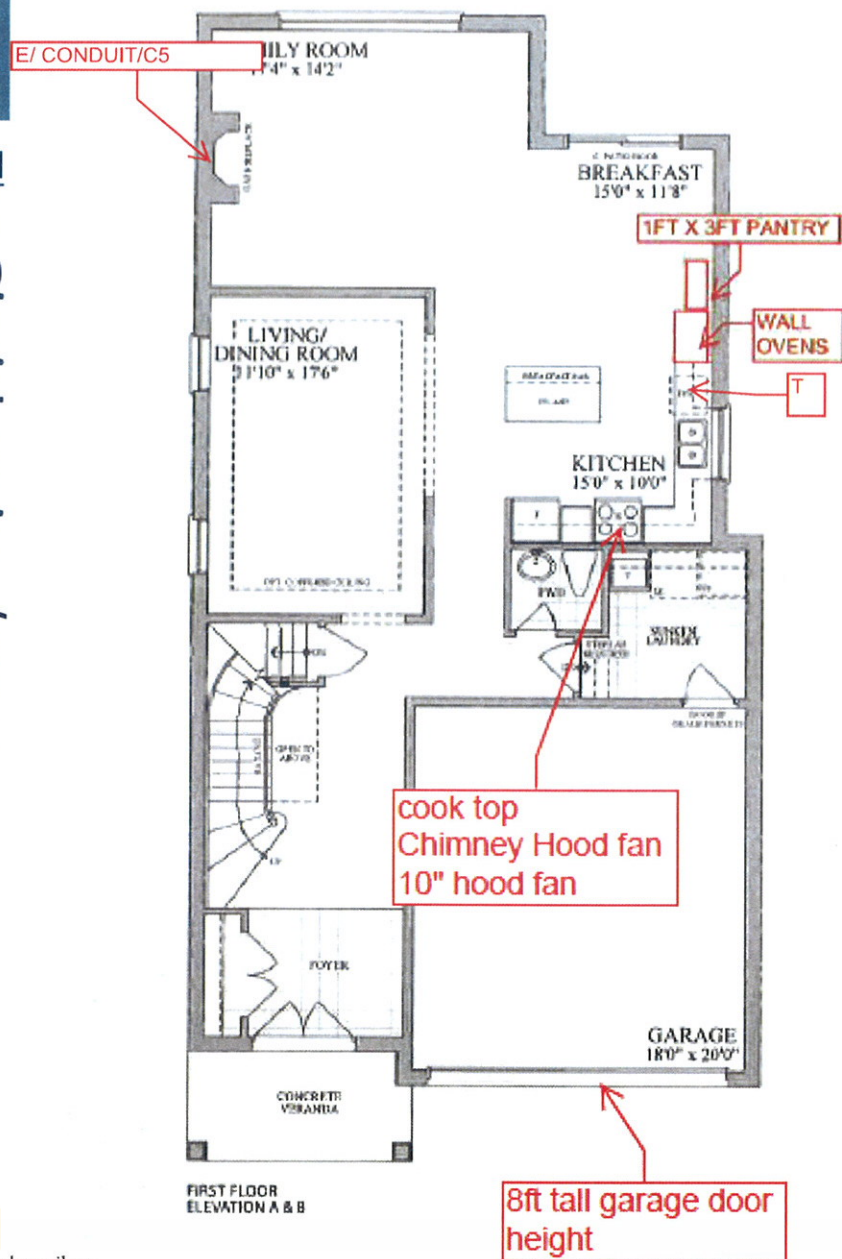


FIRST FLOOR
ELEVATION A & B

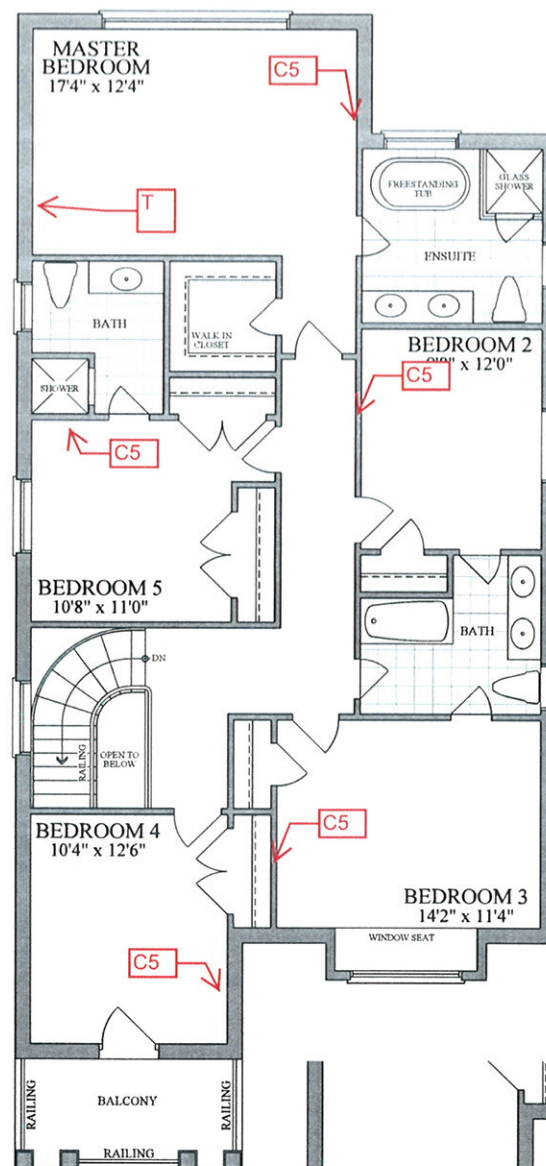

SECOND FLOOR
ELEVATION A

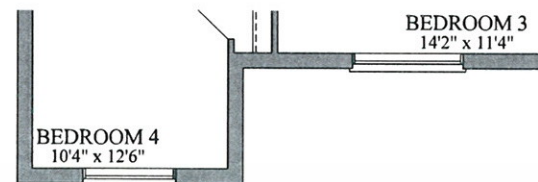

SECOND FLOOR
ELEVATION B

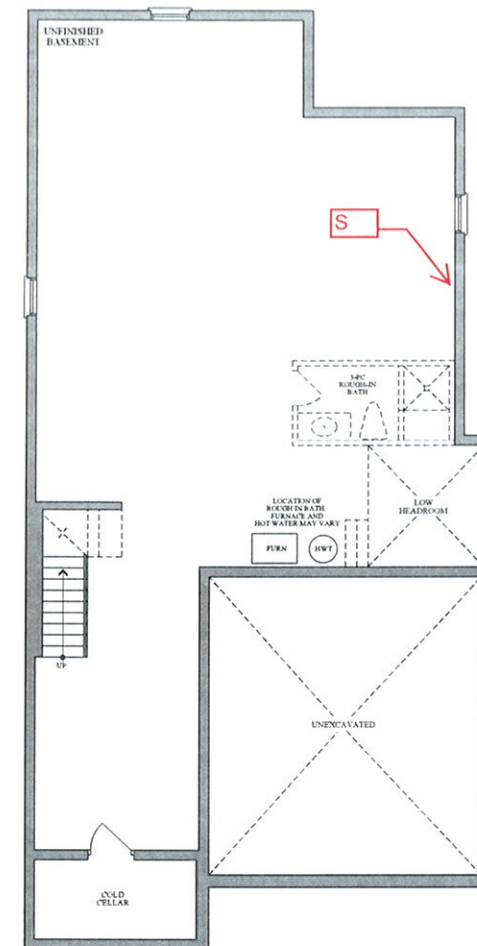

BASEMENT
ELEVATION A & B

LOT 5-84, PH5, CABLE LOCATIONS

PURCHASER:

PURCHASER:



Plans and specifications are subject to change without notice. E. & O. E. Actual usable floor space may vary from the stated floor area. All renderings are artist's concept.