



forming part of the Agreement of Purchase and Sale

BELLAIRE PROPERTIES INC.

P.E.#: 003

No.	DESCRIPTION	PRICE
1	Further to item #18 on PE-002, Purchaser agrees to reduce the width of the closet and shift the door to Bedroom 4 in order to accommodate the wall and doors to the Study	
		Extra's Subtotal:
		H.S.T.
		New Total:
		Less Bonus Package (if Applicable)
		TOTAL:
		TOTAL


- The Vendor will undertake to install the above extras but will not be liable to the purchaser if for any reason the work covered by the extra is not carried out. In that event, the price of the extra shall be refunded to the purchaser without any interest.
- It is understood and agreed that if the transaction of Purchase and Sale is not completed for any reason whatsoever, the total cost of this extra is not refundable.

PURCHASER

Pedro Ferreira (Feb 7, 2022 15:43 EST)
PURCHASER

Per: _____
VENDC

(Original verified at Head Office)

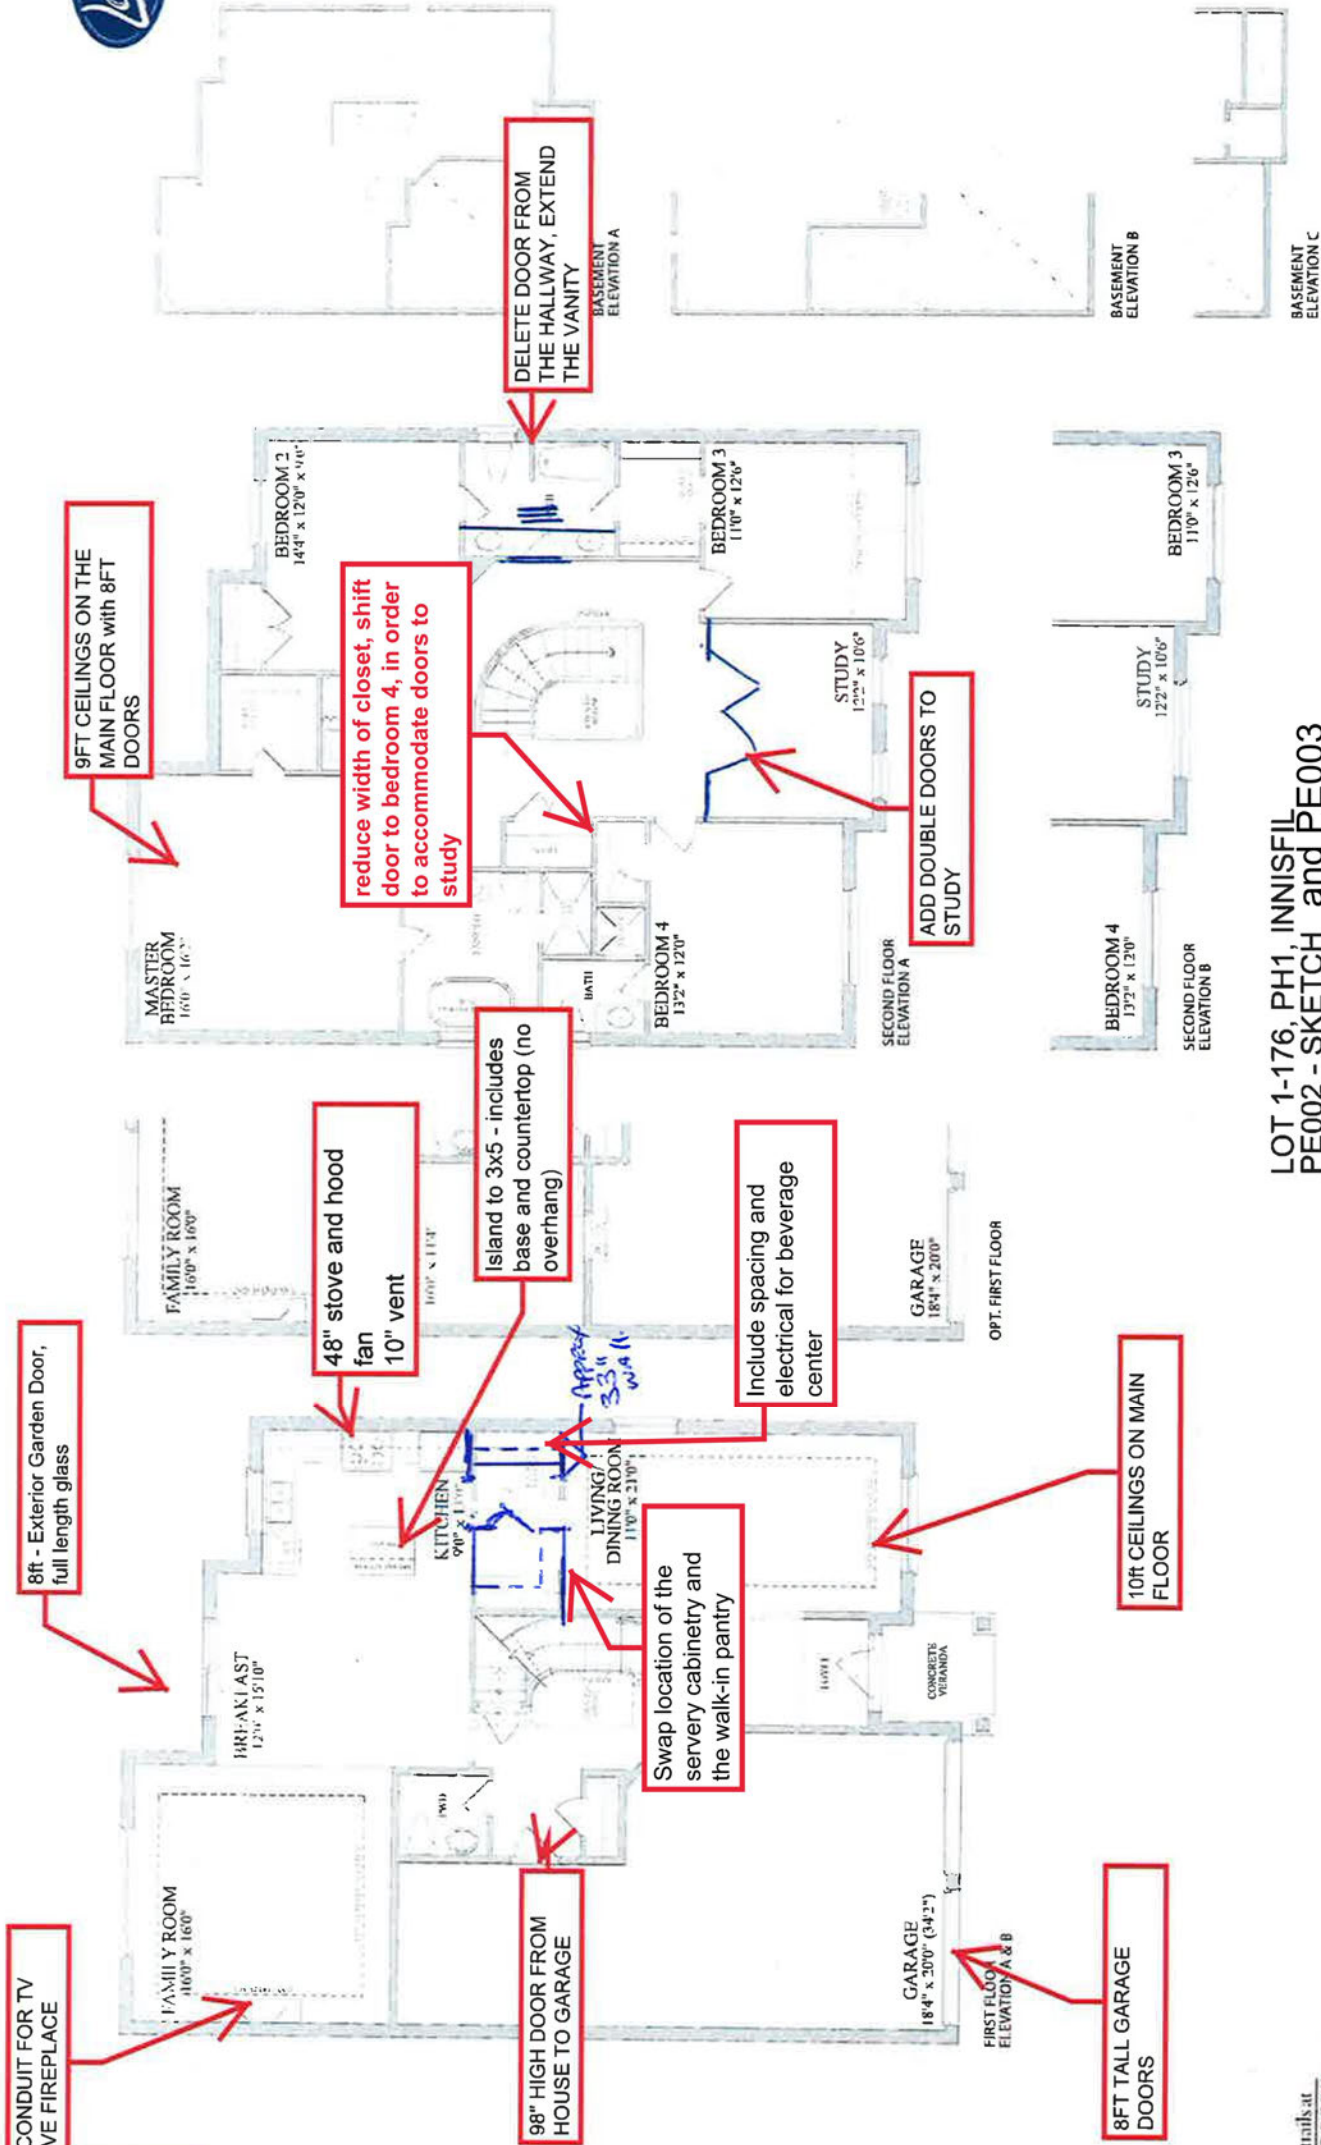

The **Carlyle** / Elev. A & B
2950 sq.ft.

LOT 1-176, PH1, INNISFIL
PE002 - SKETCH and PE003

PURCHASER: *Amanda Ferreira* (Feb 7, 2022 15:10 EST)

PURCHASER: *Pedro Ferreira* (Feb 7, 2022 15:43 EST)

Plans and specifications are subject to change without notice. E & O E. Actual usable floor space may vary from the stated floor area. All measurements are within a 1/8" tolerance.