



38'
DESIGNS


The Superior / Elev. A & B
3 Car Tandem 3400 sq.ft. - includes 530 sq. ft. of finished area in lower level
2 Car Garage 3615 sq.ft. - includes 748 sq. ft. of finished area in lower level

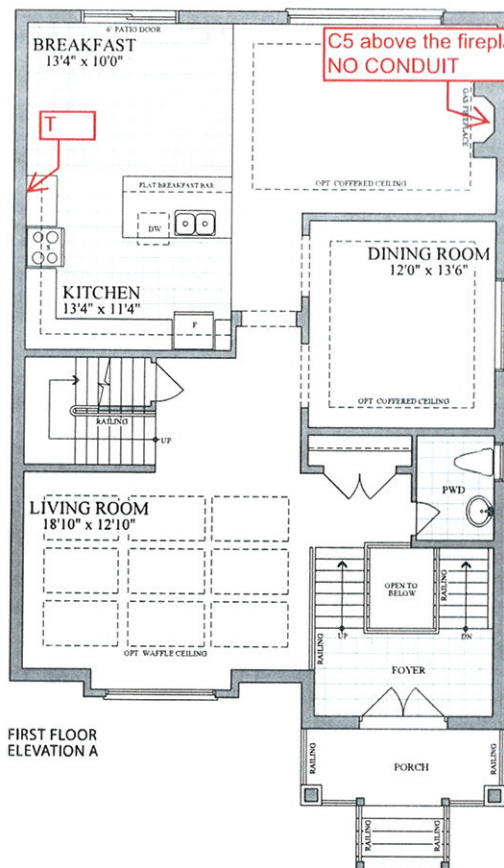


FIRST FLOOR
ELEVATION A

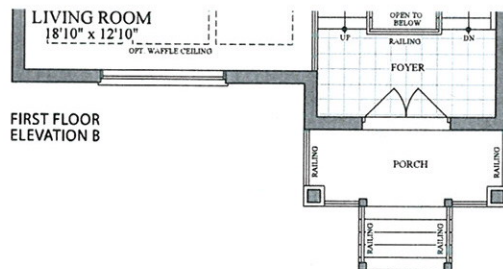


FIRST FLOOR
ELEVATION B

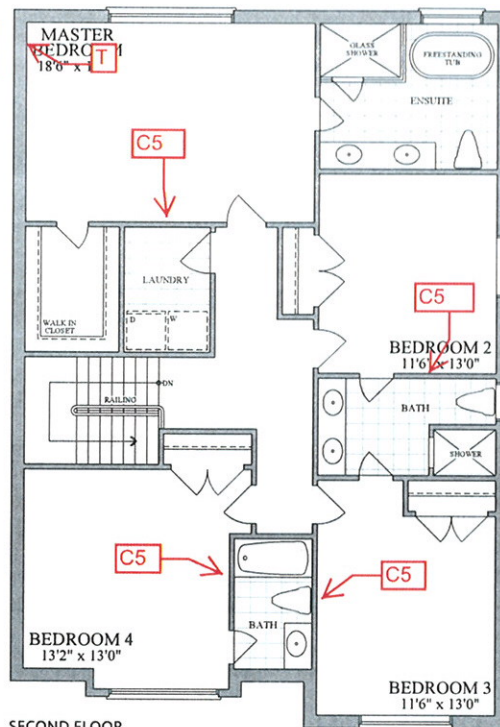


SECOND FLOOR
ELEVATION A

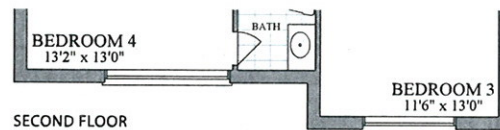

SECOND FLOOR
ELEVATION B

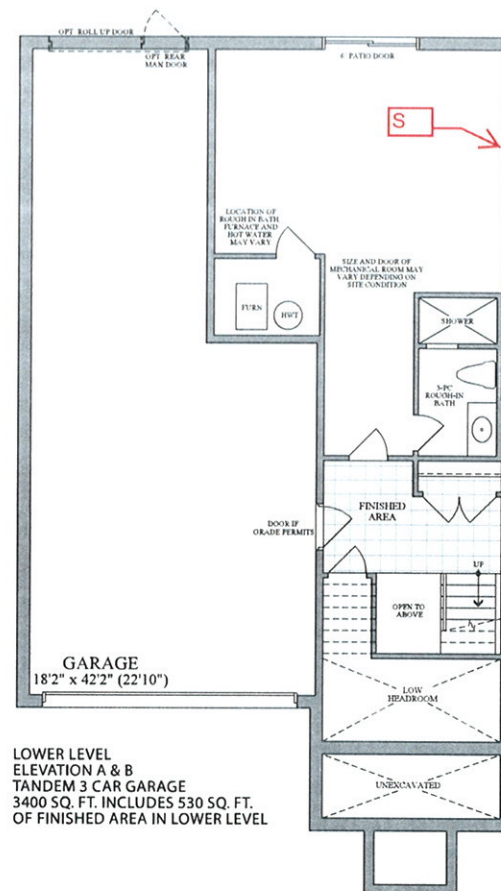

LOWER LEVEL
ELEVATION A & B
TANDEM 3 CAR GARAGE
3400 SQ. FT. INCLUDES 530 SQ. FT.
OF FINISHED AREA IN LOWER LEVEL

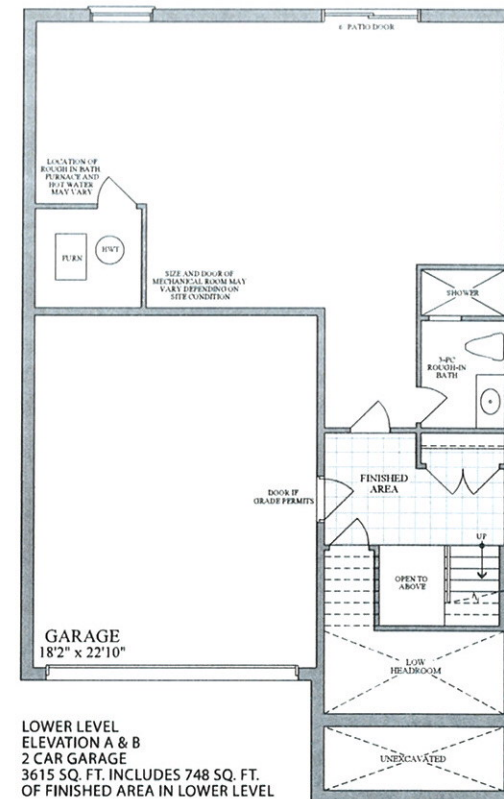

LOWER LEVEL
ELEVATION A & B
2 CAR GARAGE
3615 SQ. FT. INCLUDES 748 SQ. FT.
OF FINISHED AREA IN LOWER LEVEL

Please indicate the location of the rough-ins on your plan

Description	Symbol on Sketch	Standard Locations
Cable (Rough-in)	C	Family room Or Great Room, all bedrooms, Study/Den/Computer, (as per model)
Cat5	C5	A Cat5 wire can replace the rough-in cable at no additional cost.
Cat6	C6	Upgrade - \$50 per location
Telephone (Rough-in)	T	Kitchen and Primary Ensuite
Smart-Wire (Cat5)	S	Can be installed a Purchaser's desired location

LOT: 5-48

PURCHASER:

PURCHASER: _____