

The Superior / Elev. A & B

3 Car Tandem 3400 sq.ft. - includes 530 sq. ft. of finished area in lower level

2 Car Garage 3615 sq.ft. - includes 748 sq. ft. of finished area in lower level

REMOVE THIS WALL AND WALL BETWEEN THE FAMILY ROOM AND DINING ROOM - DINING ROOM AND HALLWAY

8ft wide patio sliders, std height

CLOSE THIS WALL

Double door to master - shift doors closer to the laundry

Add shower niche

Decrease the master by 1ft, increase the walk-in closet by 1ft - relocate the door to closet

Relocate closet here

Add shower seat and shower niche

Reduce laundry room, provide stackable washer and dryer

8ft interior doors throughout main floor




8ft wide patio sliders, std. height

ADD DRAIN - CENTERED IN THIS AREA - APPROX 1FT FROM WALL


ADD PICTURE WINDOW

MOVE ROOM DOOR CLOSE TO CLOSET


Room size - 9ft x 7ft

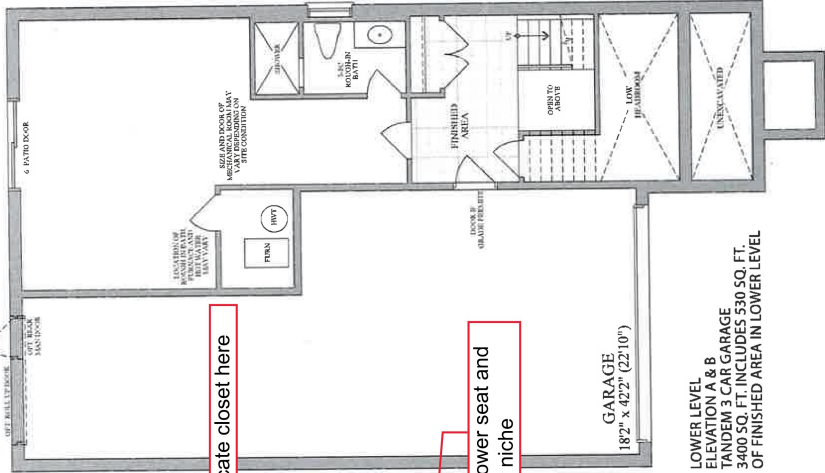


LOWER LEVEL  
ELEVATION A & B  
2 CAR GARAGE  
3615 SQ. FT. INCLUDES 748 SQ. FT.  
OF FINISHED AREA IN LOWER LEVEL

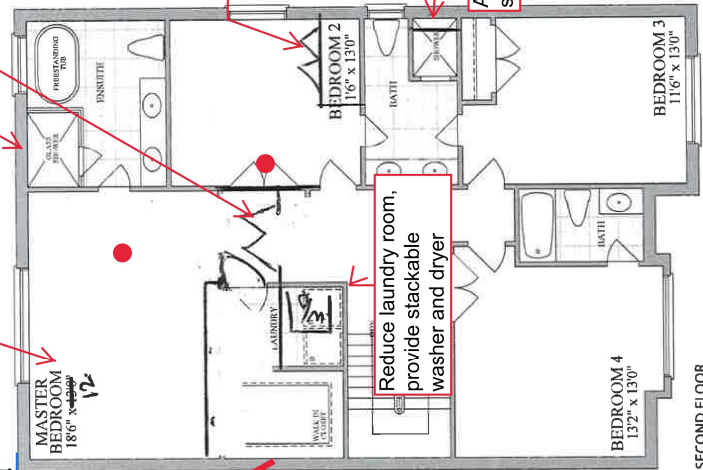


SECOND FLOOR  
ELEVATION A

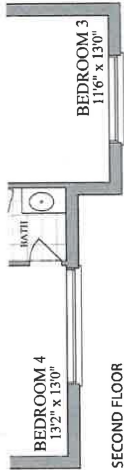

SECOND FLOOR  
ELEVATION B

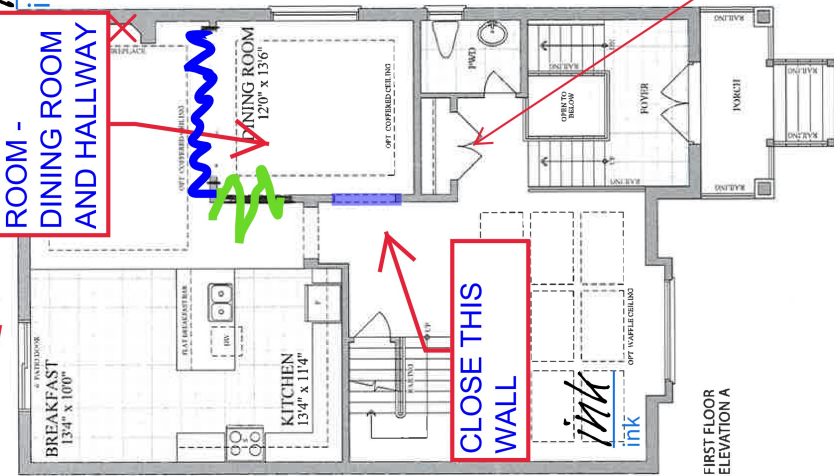

FIRST FLOOR  
ELEVATION A

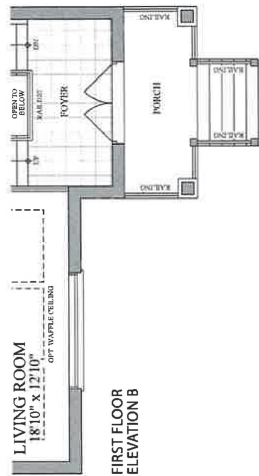

FIRST FLOOR  
ELEVATION B

LOT 5-85, PH5, PE005 - CHANGES TO LOWER LEVEL ROOM AND DINING ROOM / FAMILY ROOM

indira kabeer

indira kabeer (Aug 31, 2022 14:28 EDT)