

X = Additional ceiling light

□ = Relocate standard ceiling light

LOT 5-51, INNISFIL

005
PE ~~003~~

Purchaser's Initial(s): cc cc

Purchaser's Initial: cc

cc
cc



38'
DESIGNS




The Buckhorn / Elev. A & B
1800 sq.ft.

PROVISIONS
FOR FUTURE
WALL MOUNT
TV.

*Lights above island to
be on 1 switch

CENTER VENT
AS MUCH AS
POSSIBLE FOR
FUTURE CHIMNEY
HOOD FAN

REMOVE
NO TRIM

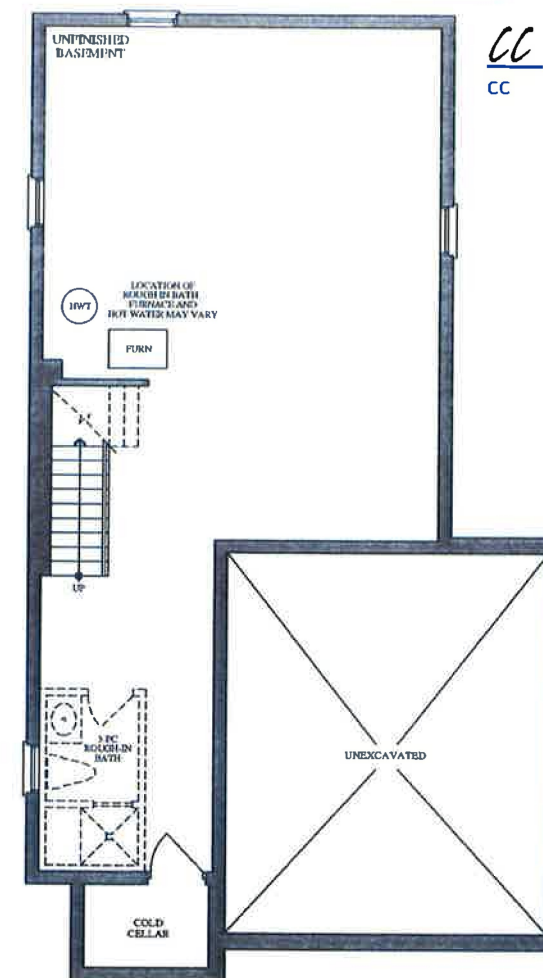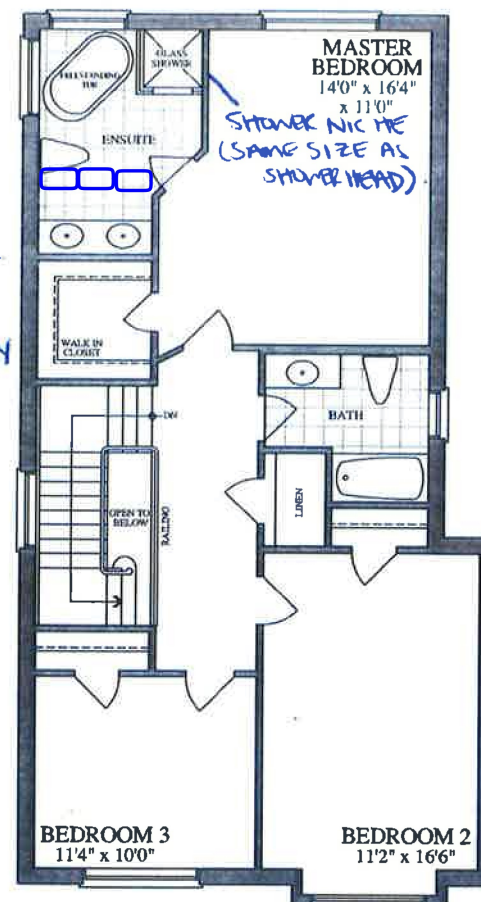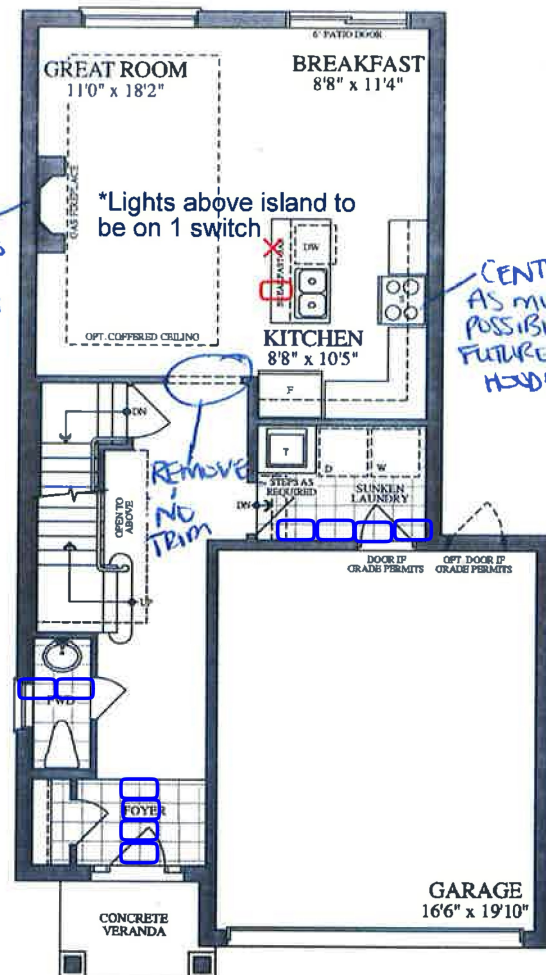

Plans and specifications are subject to change without notice. E. & O. E. Actual usable floor space may vary from the stated floor area. All renderings are artist's concept.