
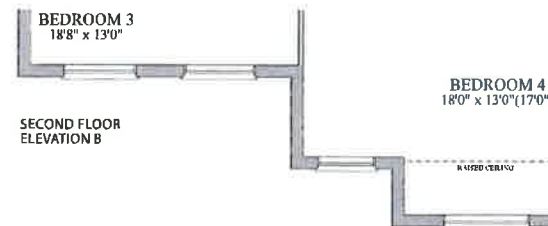
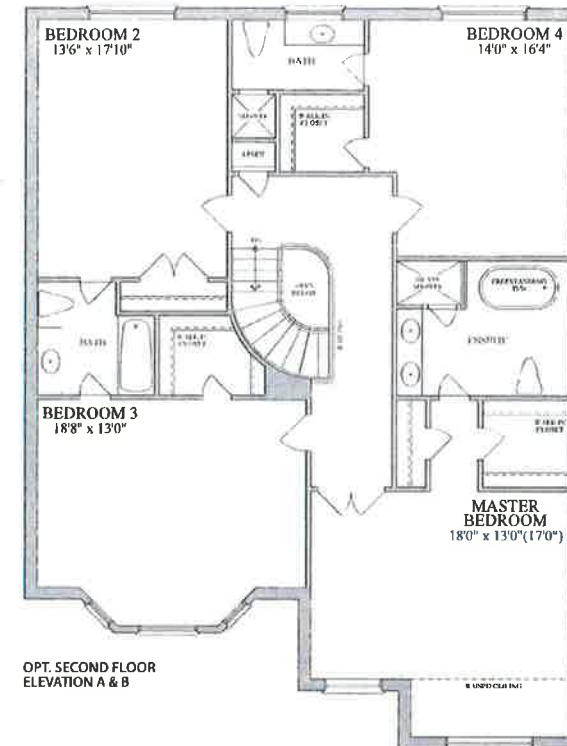



47'
DESIGNS

The **nipissing** / Elev. A & B
3210 sq.ft.

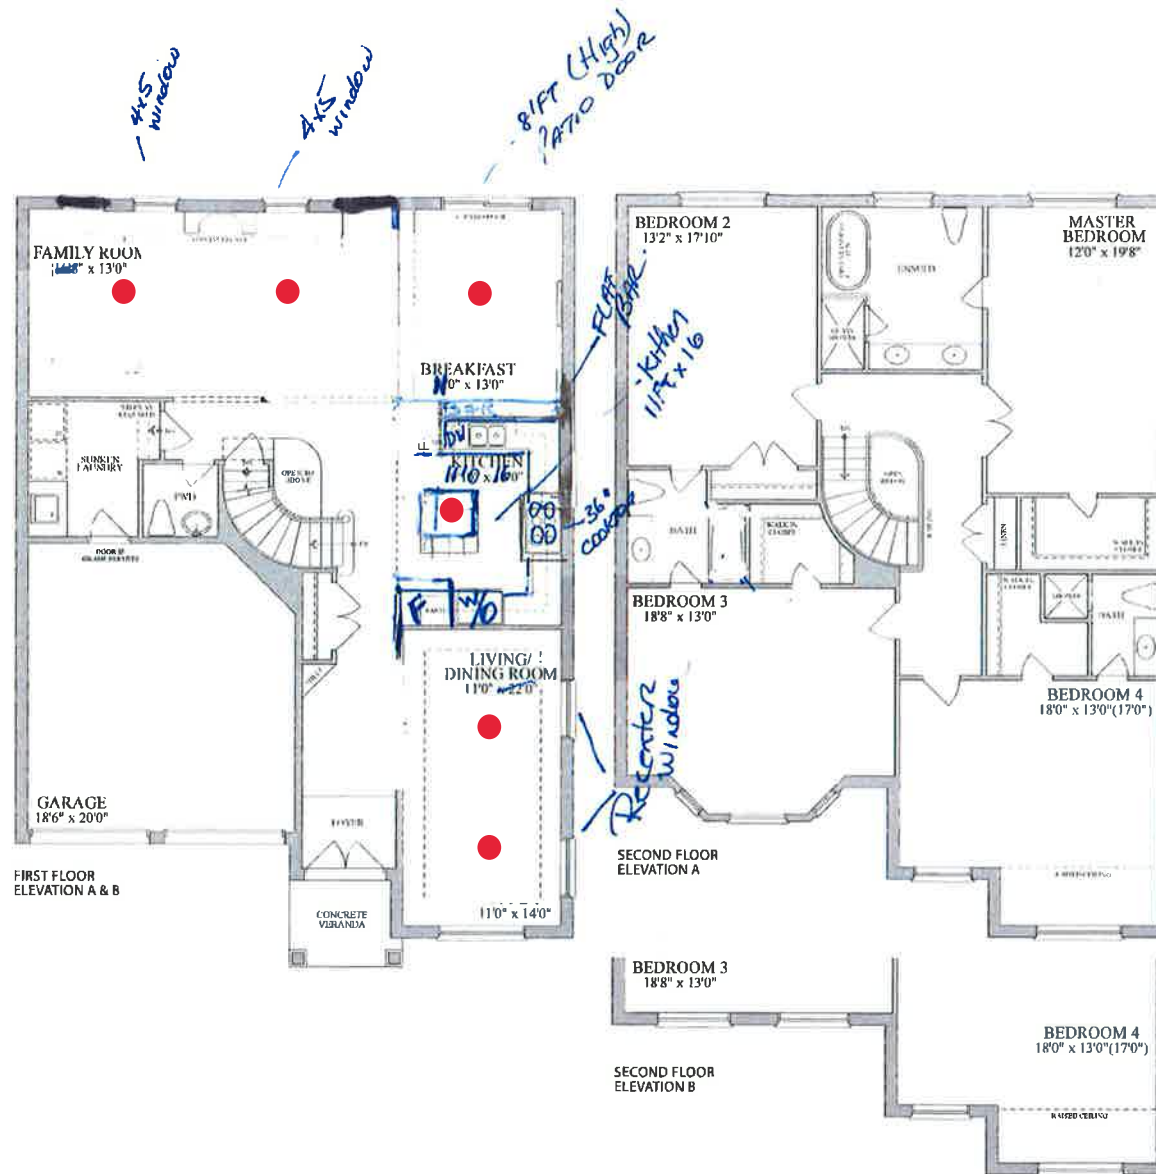

LOT 5-68, PH5, PE-005

PURCHASER: Melissa board (Oct 29, 2021 13:32 EDT)

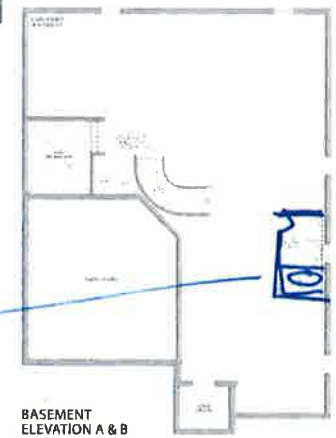

Finished
Basement
with
TUB



Plans and specifications are subject to change without notice. E. & O. E. Actual usable floor space may vary from the stated floor area. All renderings are artist's concept.