

LO 5-50, INNISFIL, PE004, SKETCH

Purchaser's Initial(s): SH MM




38' DESIGNS


The Fraser / Elev. A & B
2250 sq.ft.

change to window is no longer being done


increase window 8ft x 5ft

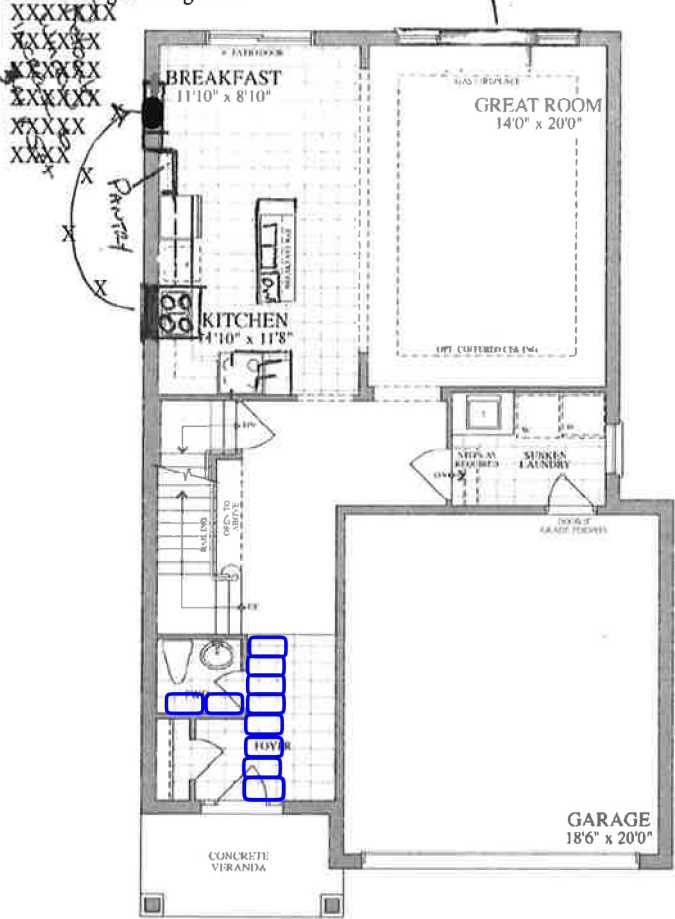


FIRST FLOOR ELEVATION A & B

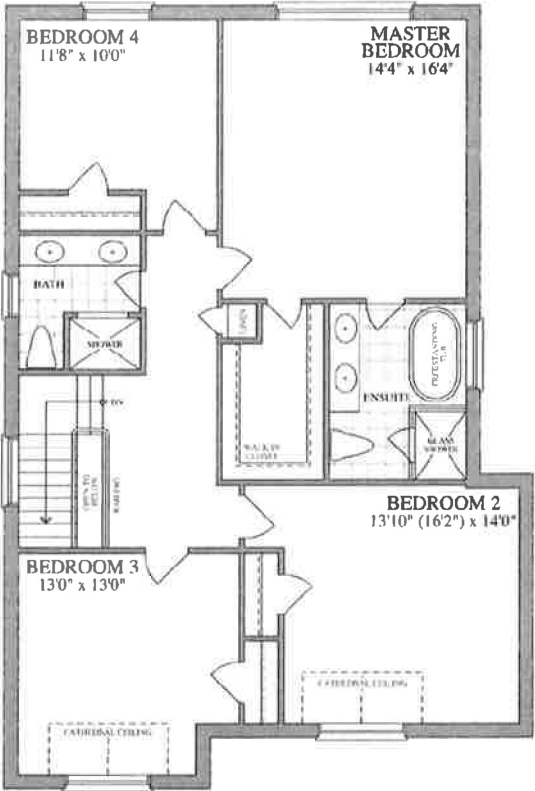

SECOND FLOOR ELEVATION A

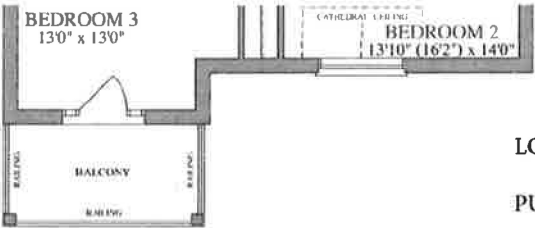

SECOND FLOOR ELEVATION B

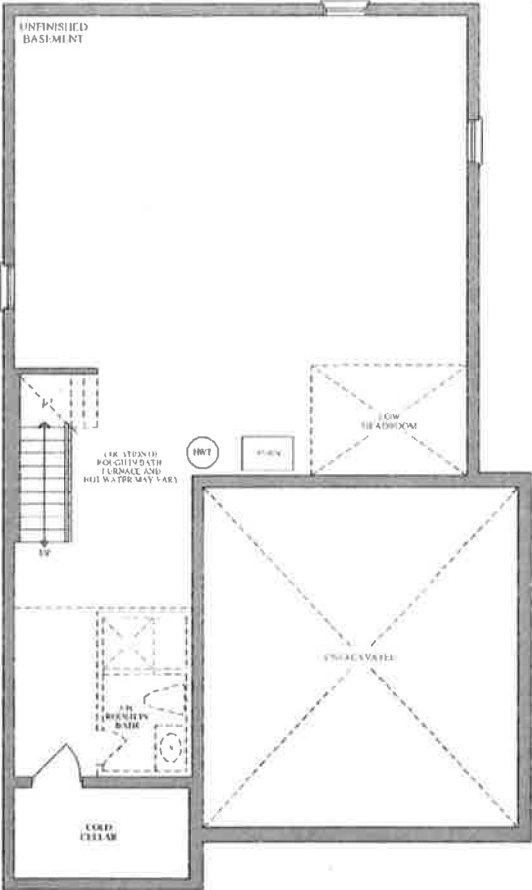

BASEMENT ELEVATION A & B

LOT 5-50, PH5, INNISFIL, PE004 SKETCH
PURCHASER: SAM HASHEMINEJAD
PURCHASER: SAM HASHEMINEJAD (Oct 27, 2021 14:07 EDT)

PURCHASER: Marianna Marano



Plans and specifications are subject to change without notice. E & O E. Actual usable floor space may vary from the stated floor area. All renderings are artist's concept.