
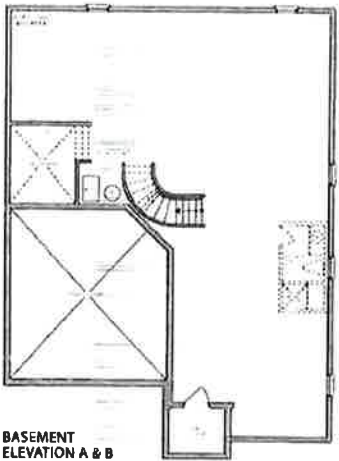
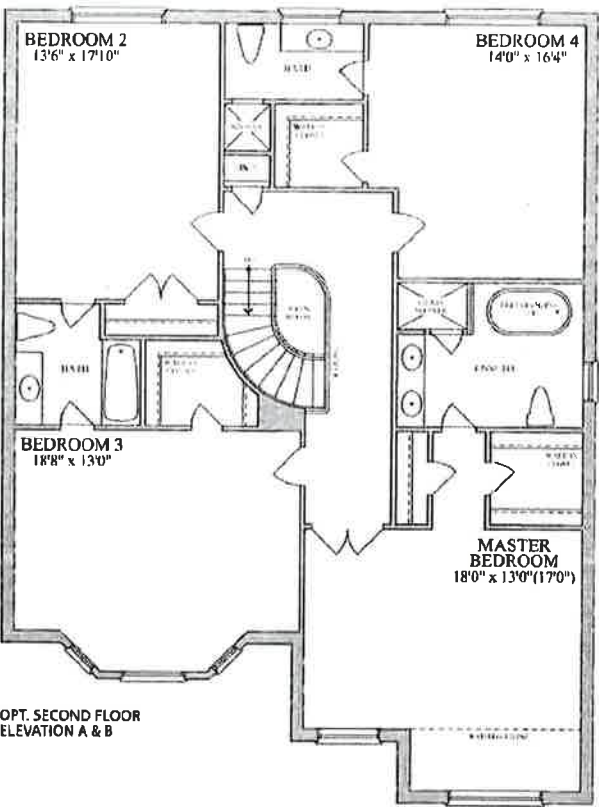
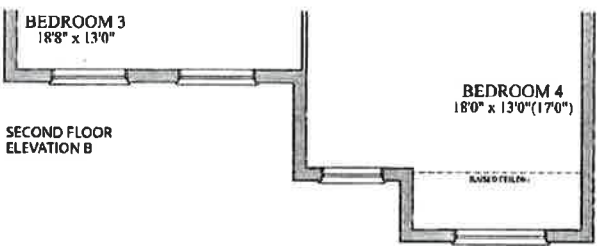
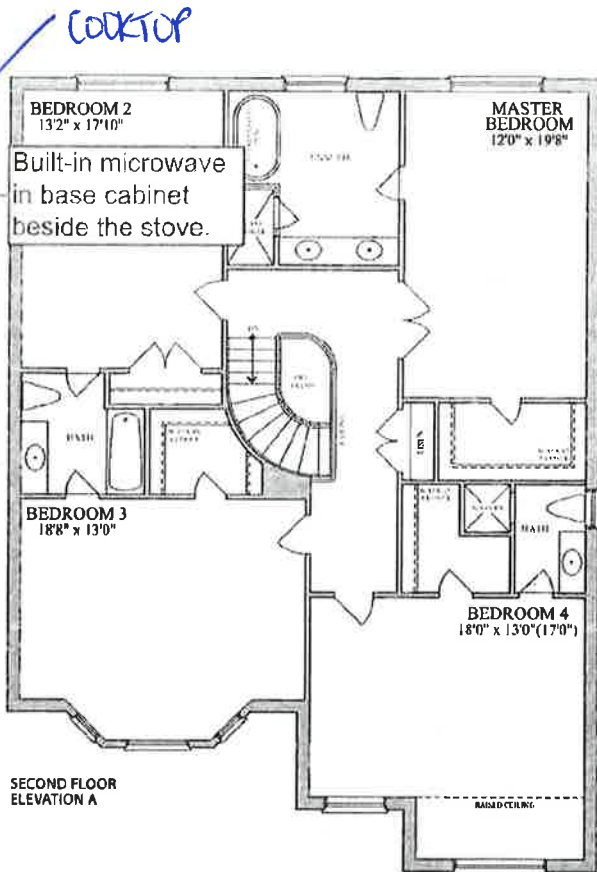


47'
DESIGNS

The nipissing / Elev. A & B
3210 sq.ft.

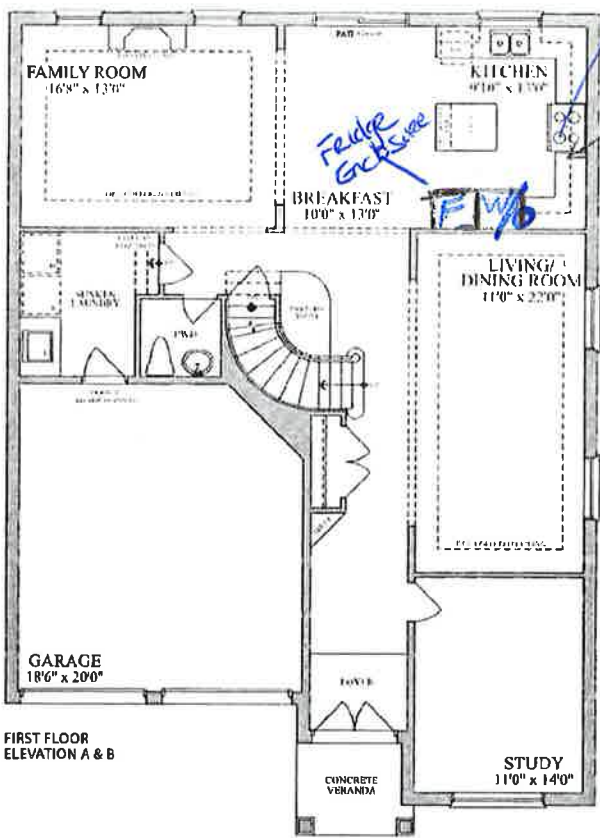

LOT 5-61, PH5: hamid samadi
hamid samadi (May 11, 2022 09:43 EDT)

Shahina samad
Shahina samad (May 10, 2022 21:46 EDT)



Plans and specifications are subject to change without notice. F & D E Actual usable floor space may vary from the stated floor area. All renderings are artist's concept.