

Lot 1-175, Ph1 - PE003, dated 10/19/2002
Revert to standard kitchen layout - purchaser has deleted built in
appliance provision, NO, fridge enclosure
Note - 8" vent remains, rough-in for pot filler remains, gas line
remains (as indicated on PE002)


Satish Sekhri

Satish Sekhri (Oct 28, 2022 13:35 EDT)



47'
DESIGNS

The nipissing / Elev. A & B
3210 sq.ft.

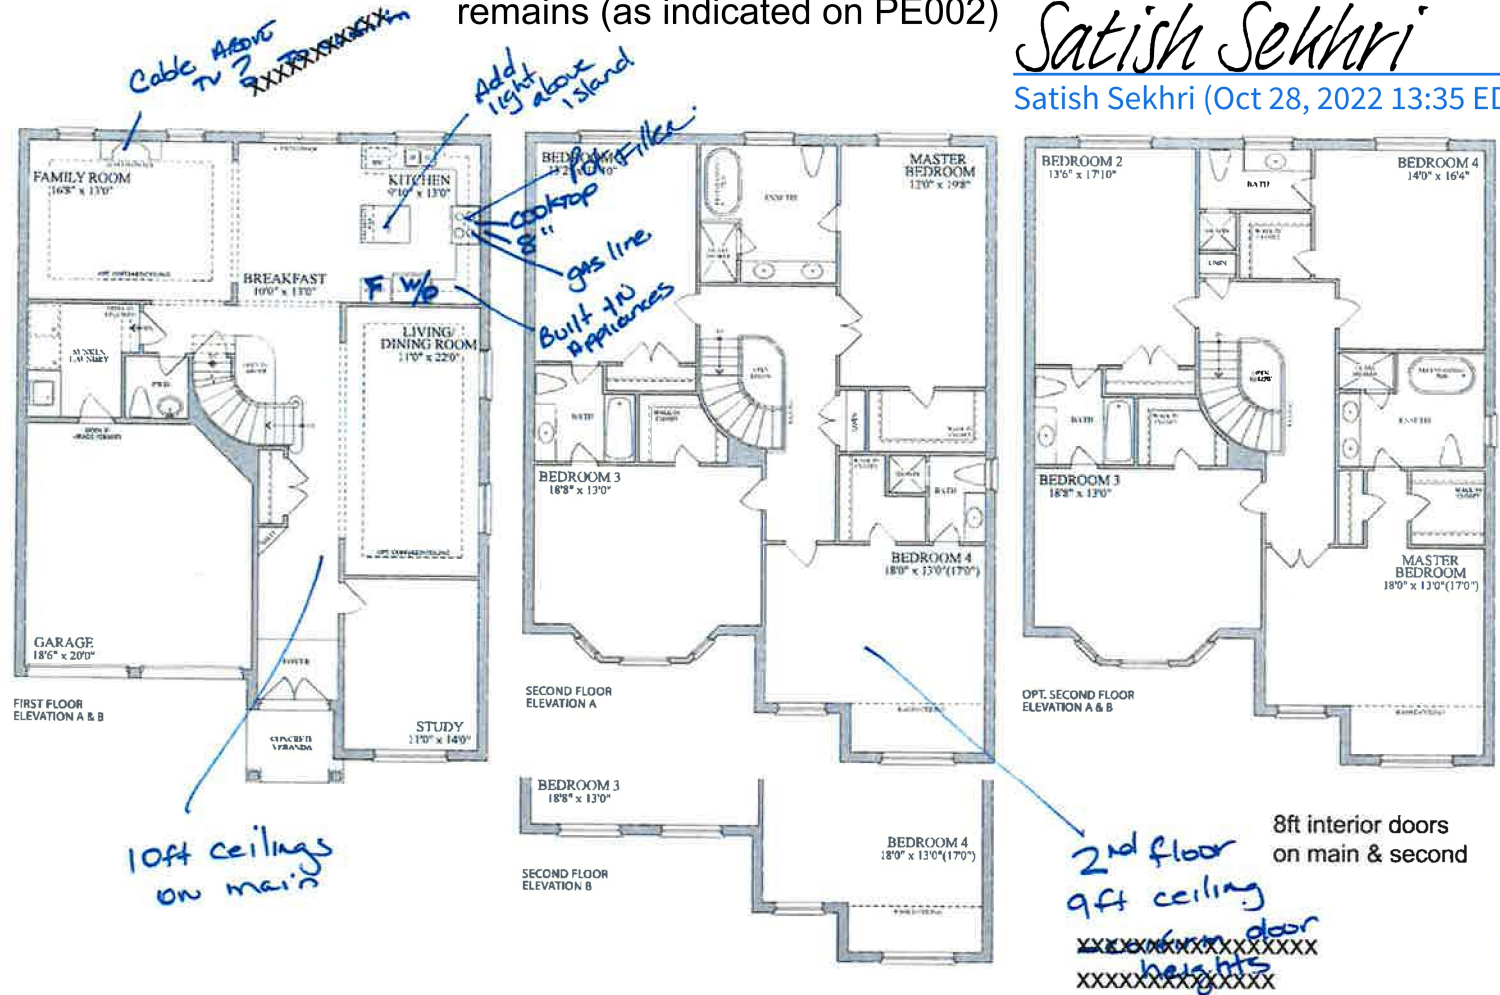

Plans and specifications are subject to change without notice, etc. Actual details from plans may vary from the actual floor area. All dimensions are in feet and inches.

Lot 1-175, PE003

Satish Sekhri

Purchaser: Satish Sekhri (Feb 9, 2022 16:31 EST)

Purchaser: _____

