


LOT 5-45, PH5, PE005


38'
DESIGNS

The Superior / Elev. A & B
Includes 748 sq. ft. of finished area in lower level


36" COOKTOP
AND 36"
CHIMNEY
HOODFAN

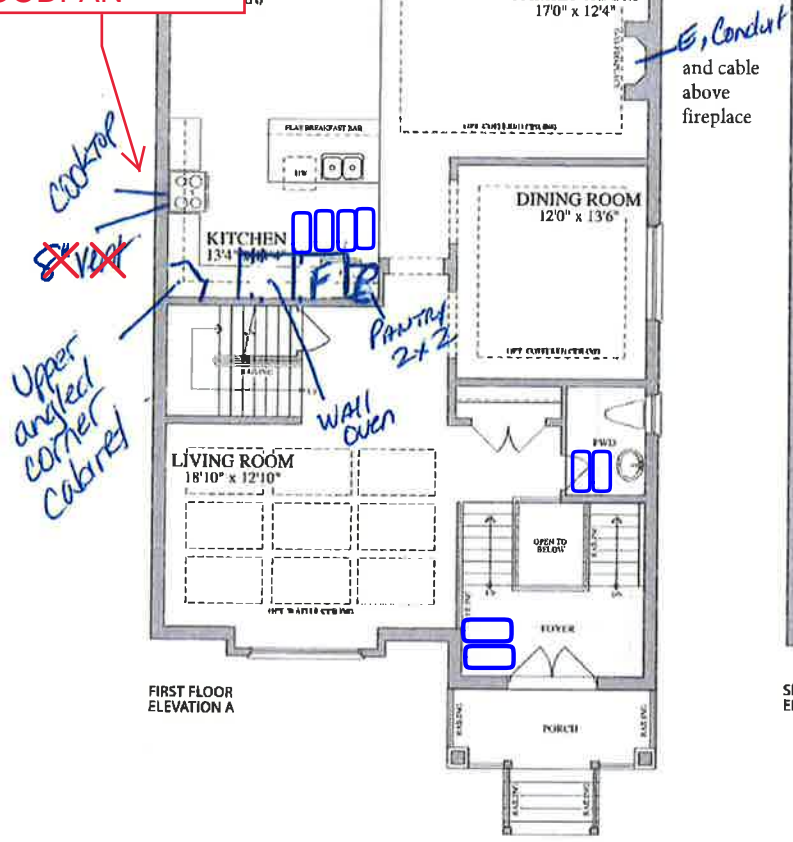


FIRST FLOOR ELEVATION A

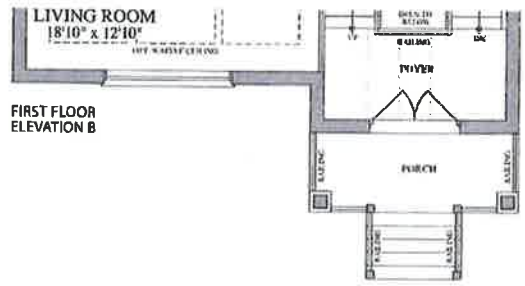


FIRST FLOOR ELEVATION B

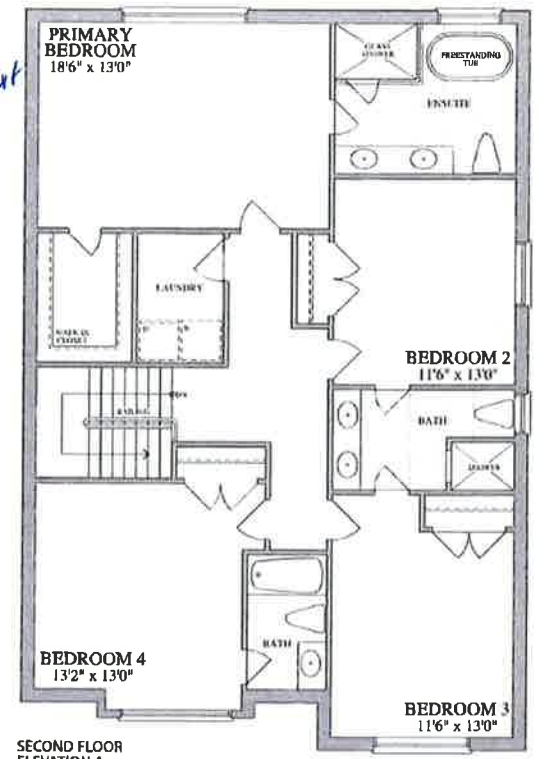

SECOND FLOOR ELEVATION A

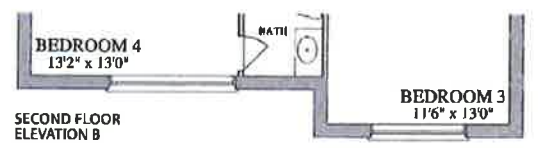

SECOND FLOOR ELEVATION B

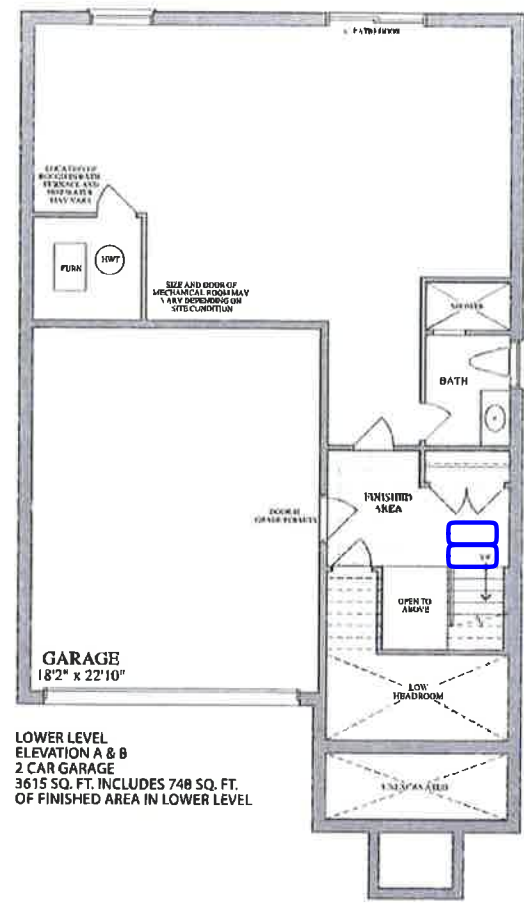

LOWER LEVEL ELEVATION A & B
2 CAR GARAGE
3615 SQ. FT. INCLUDES 748 SQ. FT. OF FINISHED AREA IN LOWER LEVEL



LOT 5-45, PH5, INNISFIL, PE003, SKETCH

PURCHASER: Hemi sheth (Nov 23, 2021 19:15 EST)

PURCHASER: _____



Plans and specifications are subject to change without notice. E. & O. E. Actual usable floor space may vary from the stated floor area. All renderings are artist's concept.