


38'
DESIGNS

The Buckhorn / Elev. A & B
1800 sq.ft.

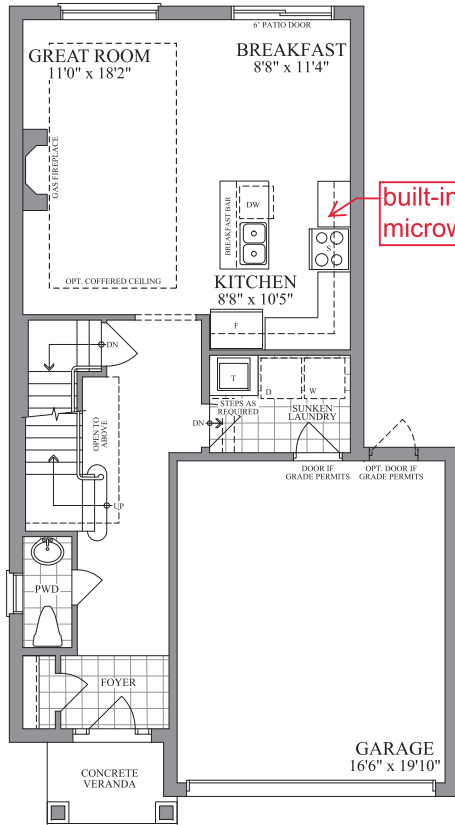


FIRST FLOOR
ELEVATION A & B


LOT 5-90, PH5, PE005

PURCHASER: *Tavia Stephenson*
Tavia Stephenson (Nov 11, 2022 13:49 MST)


built-in
microwave

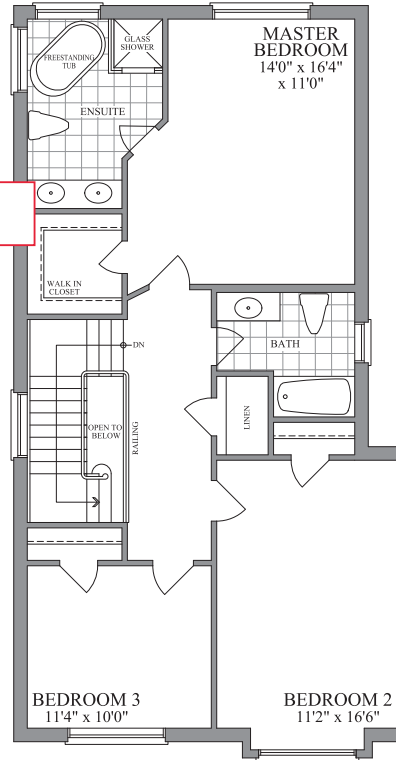

SECOND FLOOR
ELEVATION A

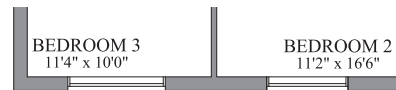

SECOND FLOOR
ELEVATION B

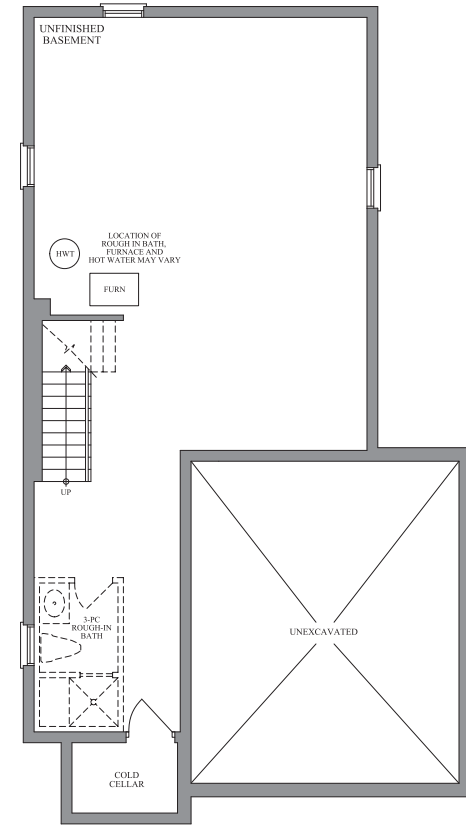

BASEMENT
ELEVATION A & B



Plans and specifications are subject to change without notice. E. & O. E. Actual usable floor space may vary from the stated floor area. All renderings are artist's concept.