
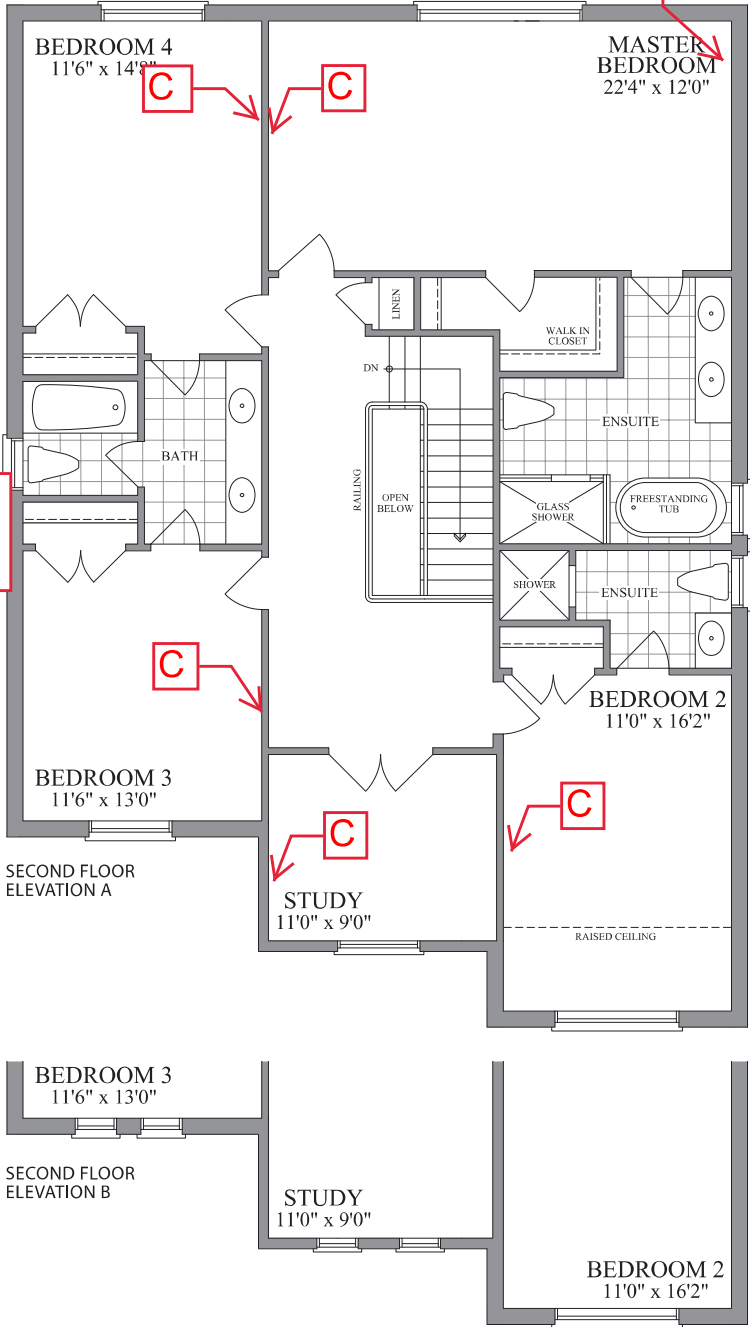


The Kahshe / Elev. A & B
3000 Sq.ft.

Purchaser's Initial(s): HM

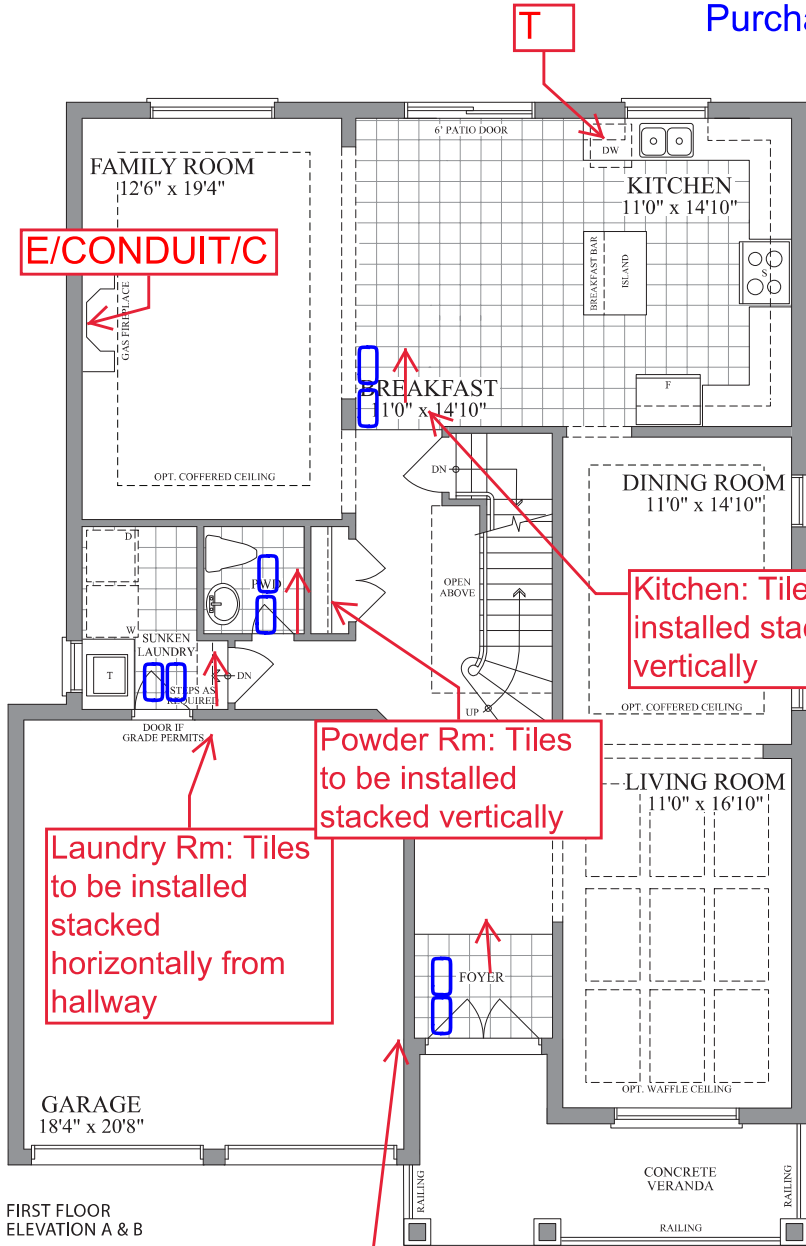

Please indicate the location of the rough-ins on your

Description	Symbol on Sketch	Standard Locations
Cable (Rough-in)	C	Family room Or Great bedrooms, Study/Den (per model)
Cat5	C5	A Cat5 wire can replace cable at no additional cost
Cat6	C6	Upgrade - \$\$\$ per location
Telephone (Rough-in)	T	Kitchen and Primary Bedroom
Smart-Wire (Cat5)	S	Can be installed at any location

LOT #: 5-63

PURCHASER: Hafsa Majid (Jun 24, 2022 10:53 MDT)

PURCHASER: _____