


LOT 5-56, INNISFIL, PE004

Purchaser's Initial(s): MS

47
DESIGN

The Kahshe / Elev. A & B
3000 sq.ft.

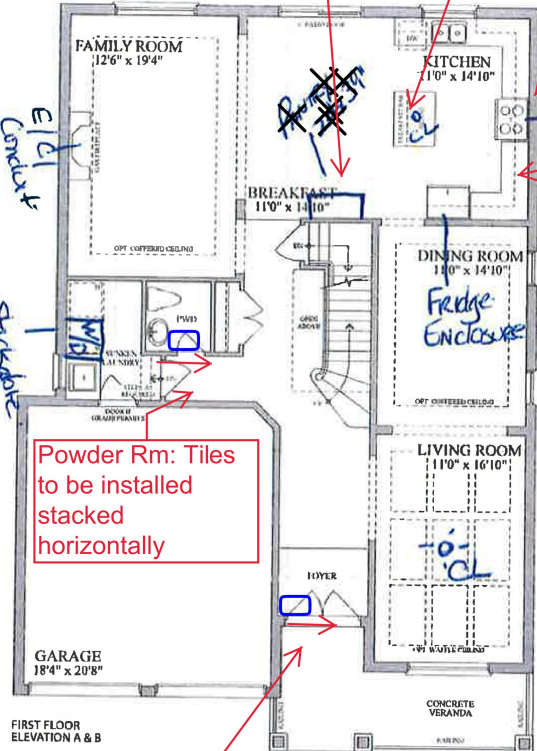

Powder Rm: Tiles to be installed stacked horizontally


Foyer: Tiles to be installed stacked horizontally

Relocate standard bank of drawers to island

Rough-in plumbing *only* pot filler

Stove & Hoodfan: 36"inch wide

One (1) set of pot & pan drawers on either side of stove space

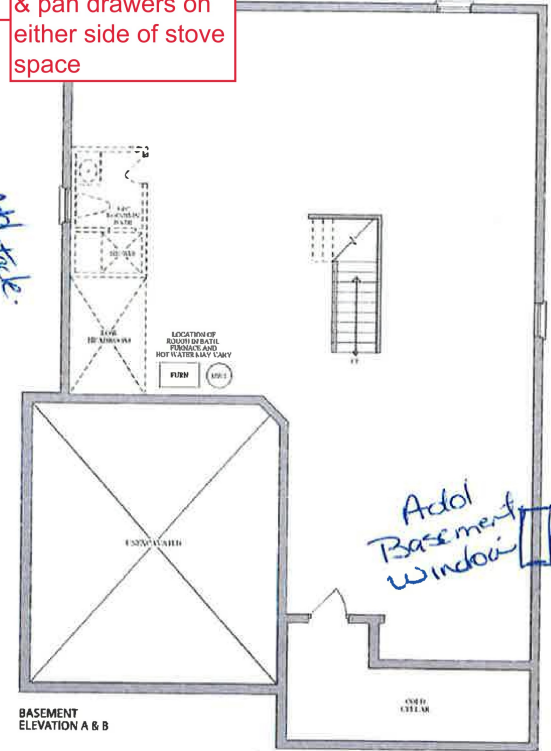

Plans and specifications are subject to change without notice. E. & D. E. Actual usable floor space may vary from the stated floor area. All renderings are artist's concept.



LOT 5-56, PH5, INNISFIL, PE002
PURCHASER: Madiha Shaikh

PURCHASER: _____