
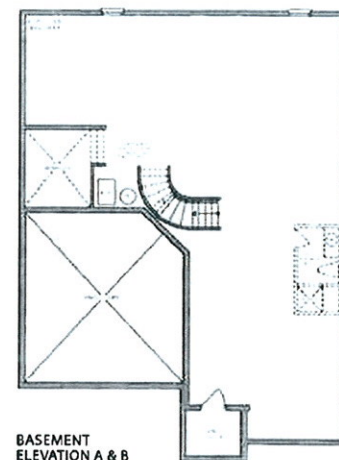
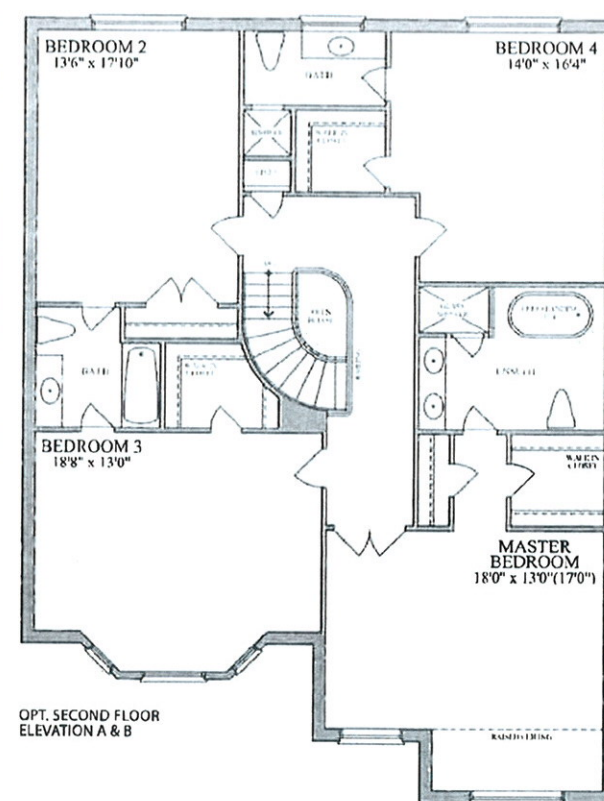
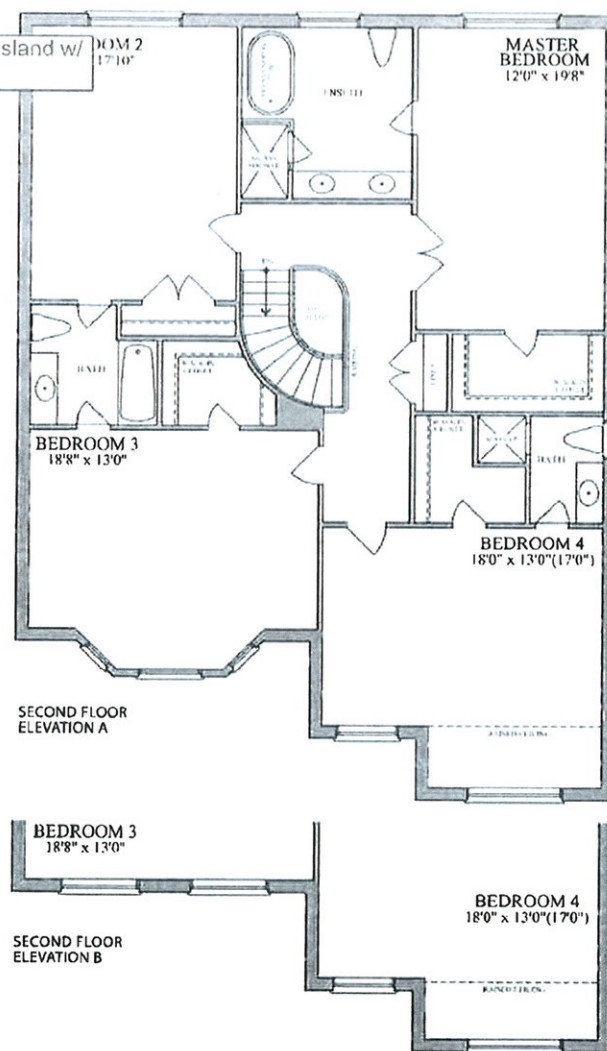


LOT 5-91, INNISFIL PE003

47'
DESIGNS

The Nipissing / Elev. A & B
3210 sq.ft.

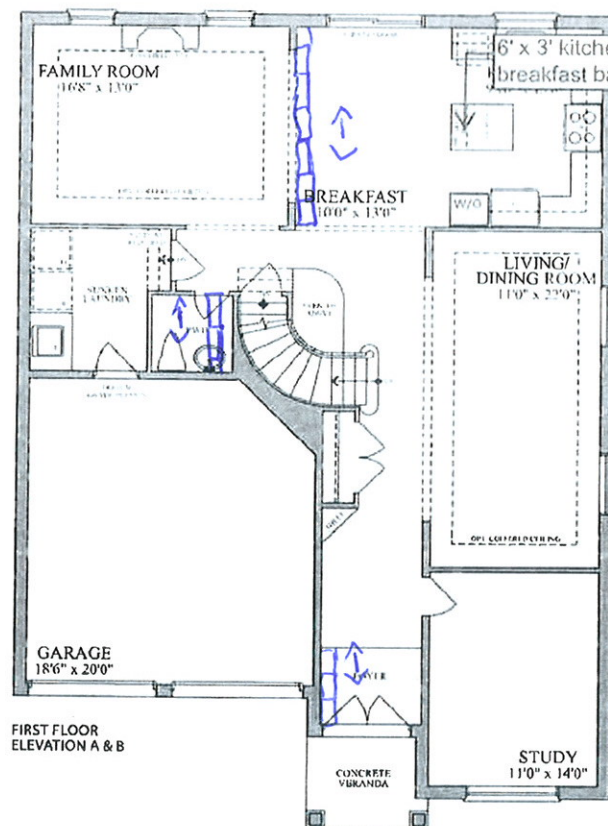

LOT 5-91 PE002

PURCHASER: SabinaAltaLuna
SabinaAltaLuna (May 17, 2022 20:29 EDT)



Plans and specifications are subject to change without notice. E & O E. Actual usable floor space may vary from the stated floor area. All renderings are artist's concept.

