


ASSOCIATION OF ONTARIO
LAND SURVEYORS
PLAN SUBMISSION FORM
2178685



THIS PLAN IS NOT VALID
UNLESS IT IS AN EXEMPTED
ORIGINAL COPY
ISSUED BY THE SURVEYOR.
In accordance with
Regulation 1026, Section 29(3).

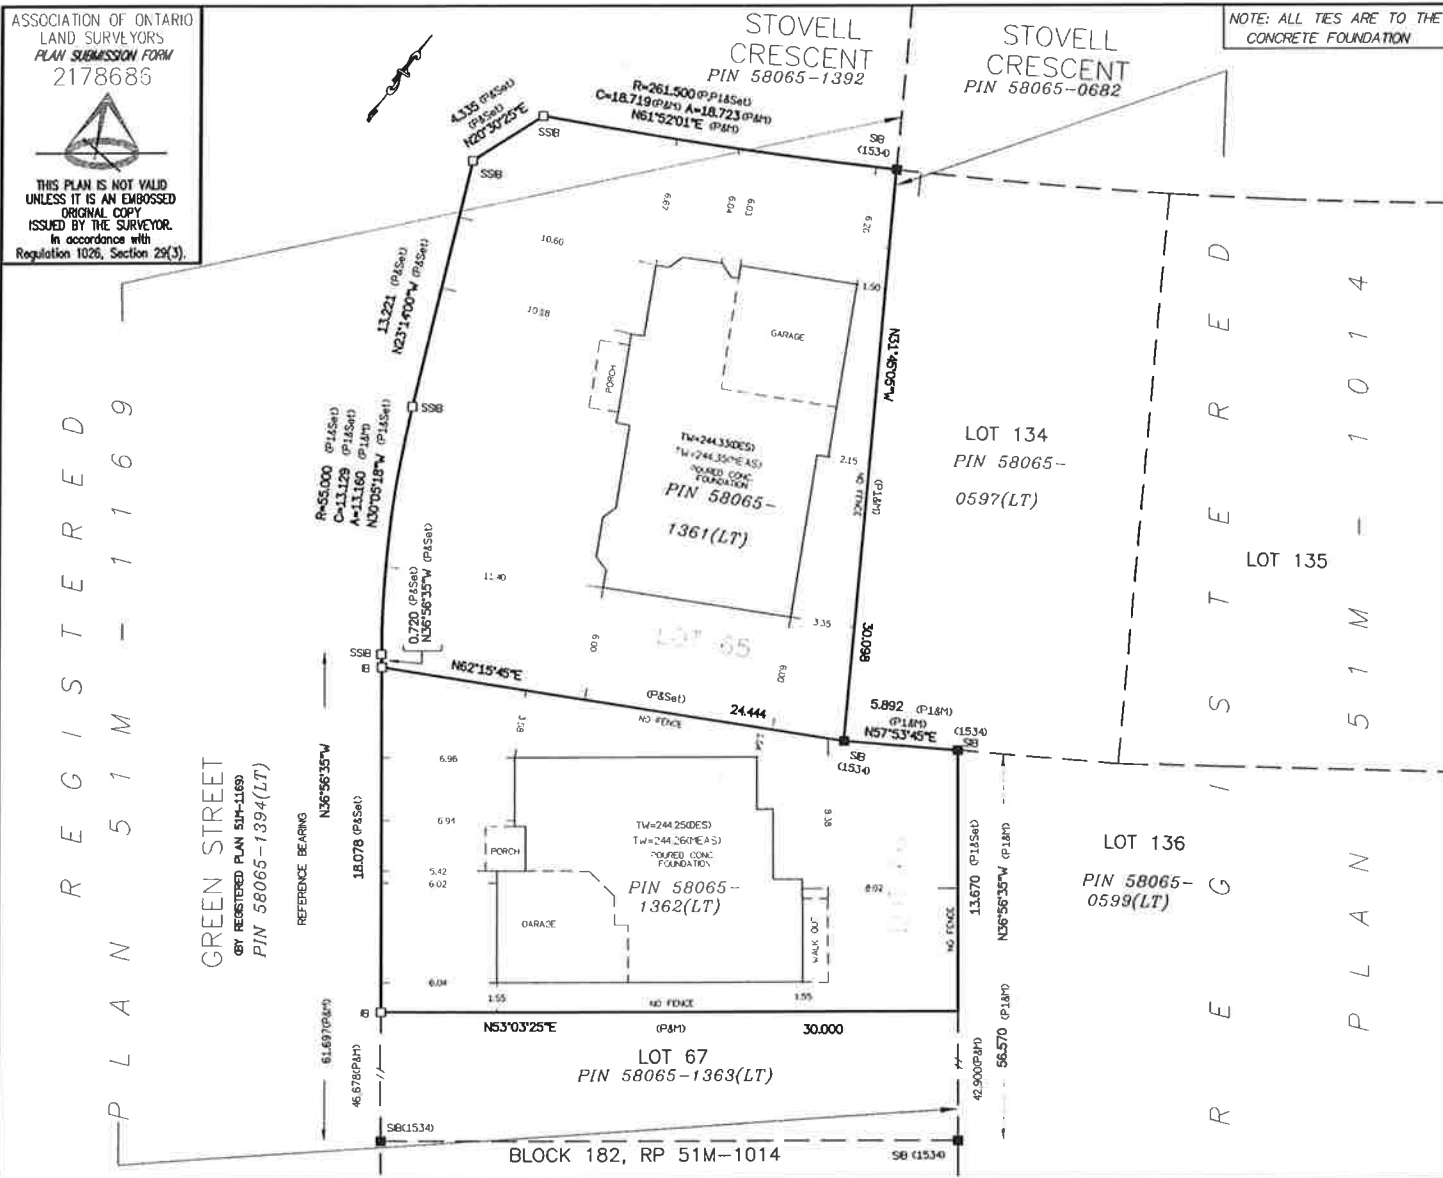


SURVEYOR'S REAL PROPERTY REPORT

PART 1:

PLAN OF
LOTS 65 AND 66
REGISTERED PLAN 51M-1169
TOWN OF INNISFIL
COUNTY OF SIMCOE

SCALE 1:250

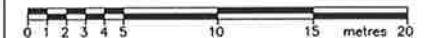

2021 © HUNT SURVEYS INC.

PART 2: THIS REPORT WAS PREPARED FOR

LORNE HOMES

TITLE SEARCH INDICATES THE FOLLOWING:
NO REGISTERED EASEMENTS OR RIGHTS-OF-WAY

METRIC: DISTANCES SHOWN ON THIS PLAN ARE IN
METRES AND CAN BE CONVERTED TO
FEET BY DIVIDING BY 0.3048

LEGEND

SYMBOL	DENOTES	SURVEY MONUMENT FOUND
SB	STANDARD IRON BAR	✓
IB	IRON BAR	✓
P	REGISTERED PLAN 51M-1169	✓
P1	REGISTERED PLAN 51M-1014	✓
C1534	DOUGLAS E. HUNT O.L.S.	✓

BEARINGS: BEARINGS ARE ASTRONOMIC AND ARE
REFERRED TO THE EASTERLY LIMIT OF GREEN STREET, AS
SHOWN ON PLAN 51M-1169 HAVING A BEARING OF N36°56'35"W.

SURVEYOR'S CERTIFICATE

I CERTIFY THAT:
1. This survey and plan are correct and in accordance
with the Surveyors Act, the Surveyors Act, the Land Titles
Act and the regulations made under them.
2. The survey was completed on December 15, 2021.
DATE: February 15, 2022 Douglas E. Hunt
Douglas E. Hunt
ONTARIO LAND SURVEYOR

HUNT SURVEYS INC. ONTARIO LAND SURVEYORS

1234 REID STREET, UNIT 7/9A, RICHMOND HILL, ON.
L4B 2P2. Tel: (905) 764-8759 Fax: (905) 764-6812
Email: huntsurveys@rogers.com

SURVEY BY: ES	CHECKED BY: DEH	FILE: 65268 srpr_65 66.dwg
CAD: O.C.	LOTS 65 & 66	PROJECT #: 065268 srpr