



BELLAIRE PROPERTIES INC. (CARSON’S CREEK)
PURCHASER EXTRAS

LOT # 089 P.E #004 – Model - FINALY - 2515 - PHASE 5

Attention Trades...

The following items below are Purchaser Extras, please make sure that they are done on time and properly complete. Any outstanding items will be Back Charged. If you have any questions please call Roberto Ruiz. Make sure that you review ALL of the items on the Purchaser Extras.

Please be advised that Purchase Orders will come at a later date.

*****Also, it is very important to speak to Roberto Ruiz before starting on site ****


TRADE: ITEMS TO BE COMPLETED

All-Tronic	#1
Internazionale Electric	#1


Date: Dec.-12-2022
From: Lormel Homes
Site Clerk: Jai Fitzgerald
Site Tel: 905-775-3633
Site Fax: 905-775-9083

NOTE: If more information is needed please call Roberto Ruiz cell-416-688-9324
If more information needed on quotes or changes, please call Zachary 905-832-2023 ext. 224




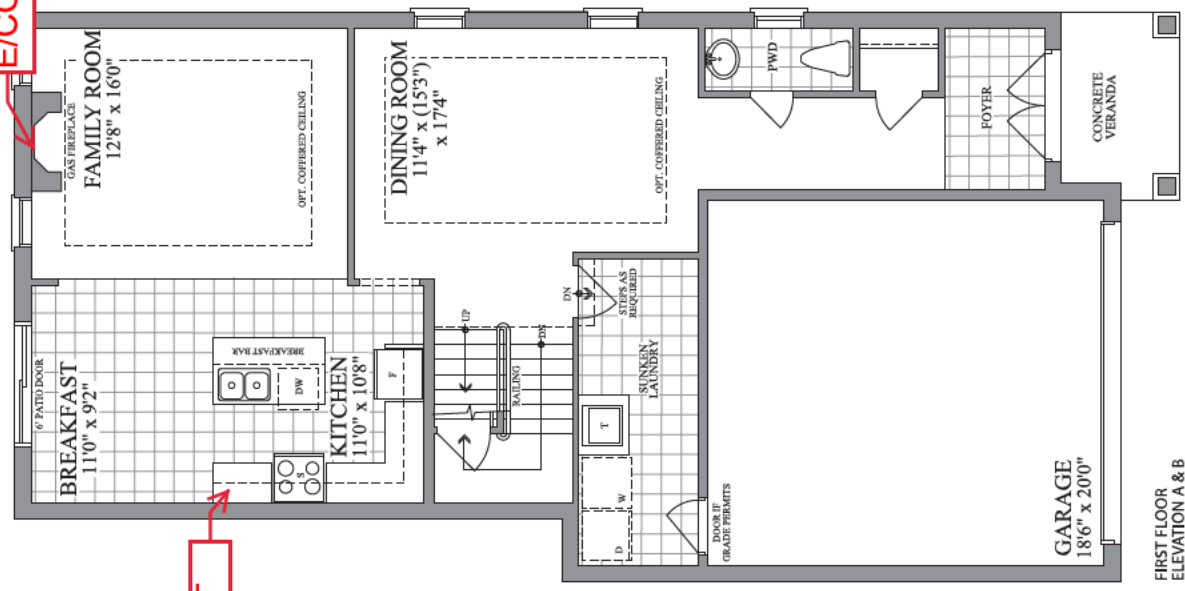


FIRST FLOOR
ELEVATION A & B

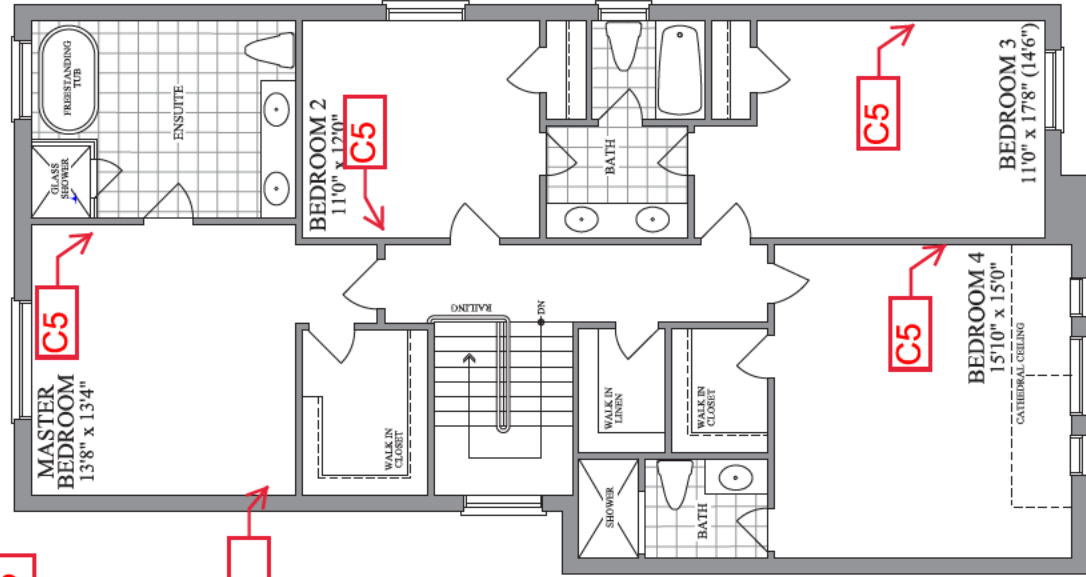

SECOND FLOOR
ELEVATION A

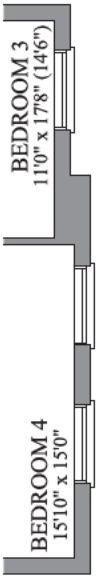

SECOND FLOOR
ELEVATION B

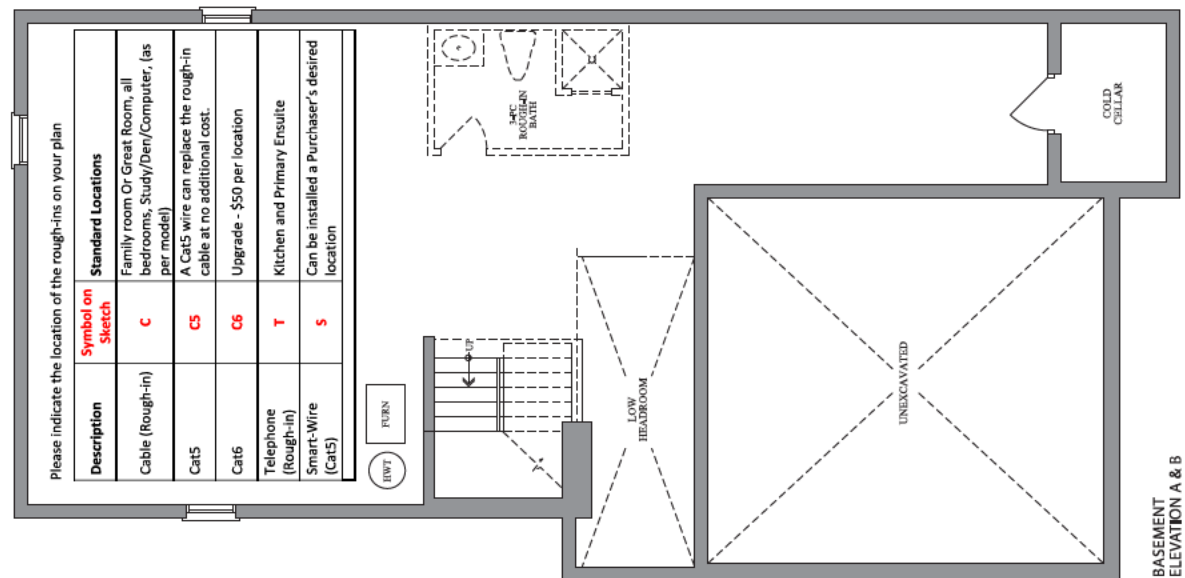

BASEMENT
ELEVATION A & B

Please indicate the location of the rough-ins on your plan		
Description	Symbol on Sketch	Standard Locations
Cable (Rough-in)	C	Family room Or Great Room, all bedrooms, Study/Den/Computer, (as per model)
Cat5	C5	A Cat5 wire can replace the rough-in cable at no additional cost.
Cat6	C6	Upgrade - \$50 per location
Telephone (Rough-in)	T	Kitchen and Primary Ensuite
Smart-Wire (Cat5)	S	Can be installed a Purchaser's desired location

LOT #: **5-89**


PURCHASER: *Mania* Usman (Dec 9, 2022 17:34 EST)

PURCHASER: *Mania* Maria Gul (Dec 10, 2022 09:09 EST)


Plans and specifications are subject to change without notice, E.A.C.O.E. Actual usable floor space may vary from the stated floor area. All renderings are artist's concepts.

38'
DESIGNS

The Finlay / Elev. A & B
2515 Sq.ft.

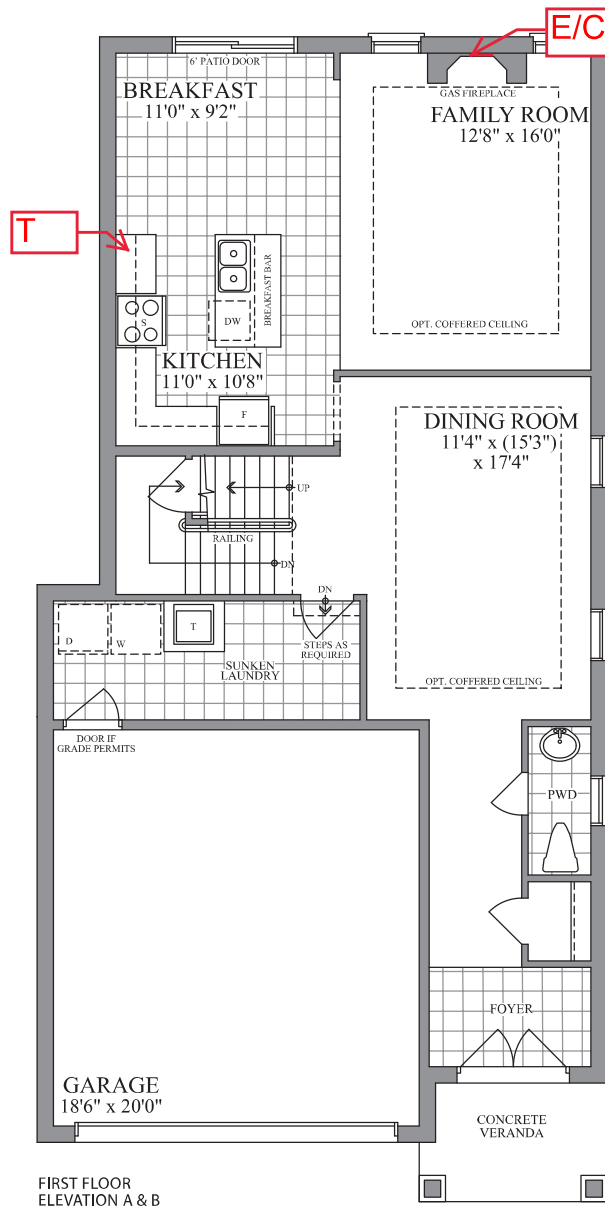


FIRST FLOOR
ELEVATION A & B

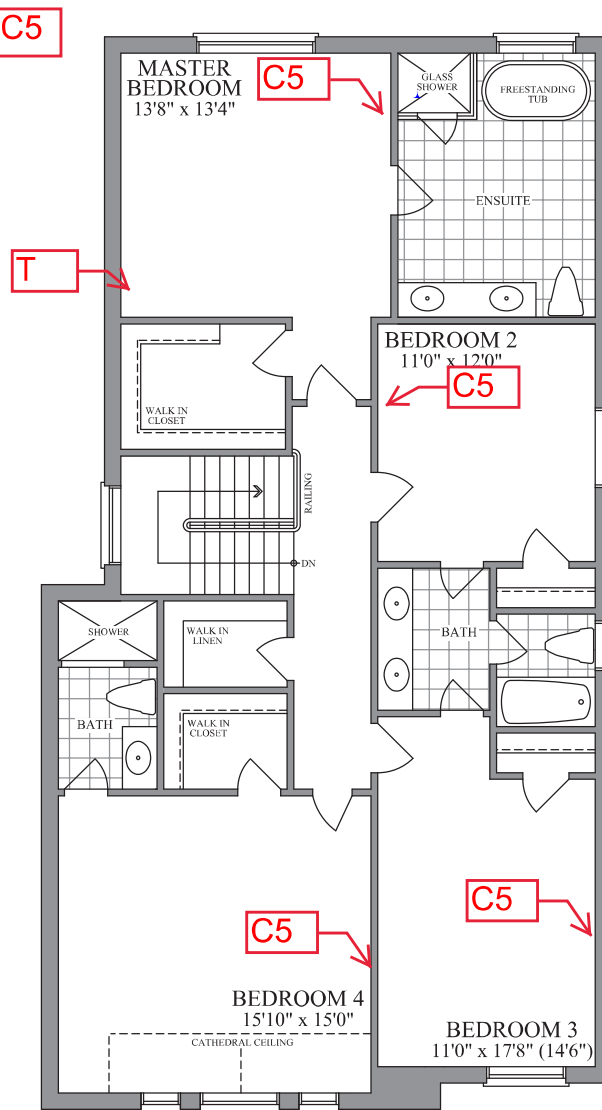

SECOND FLOOR
ELEVATION A



SECOND FLOOR
ELEVATION B

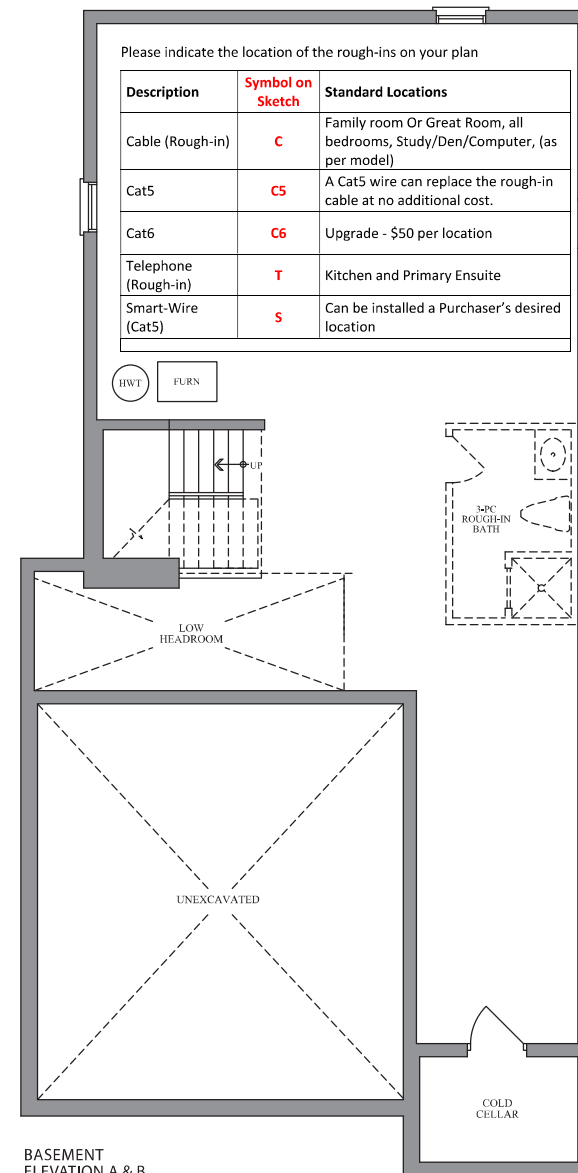

BASEMENT
ELEVATION A & B

LOT #: 5-89

PURCHASER: Usman (Dec 9, 2022 17:34 EST)

PURCHASER: Maria Gul (Dec 10, 2022 09:09 EST)



Plans and specifications are subject to change without notice, E, & O, E. Actual usable floor space may vary from the stated floor area, All renderings are artist's concept.