
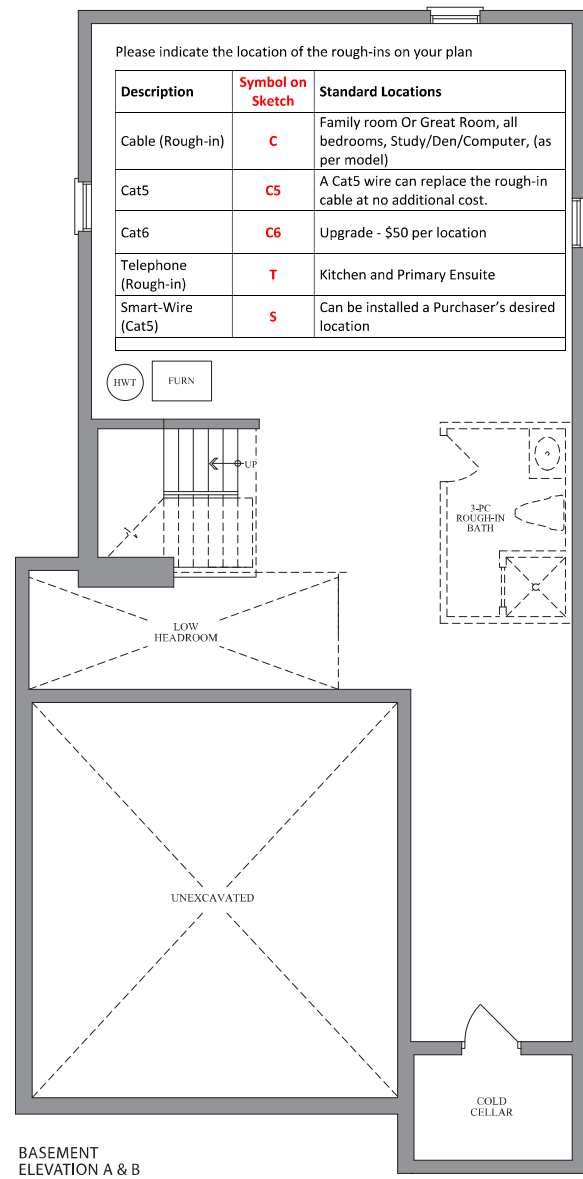
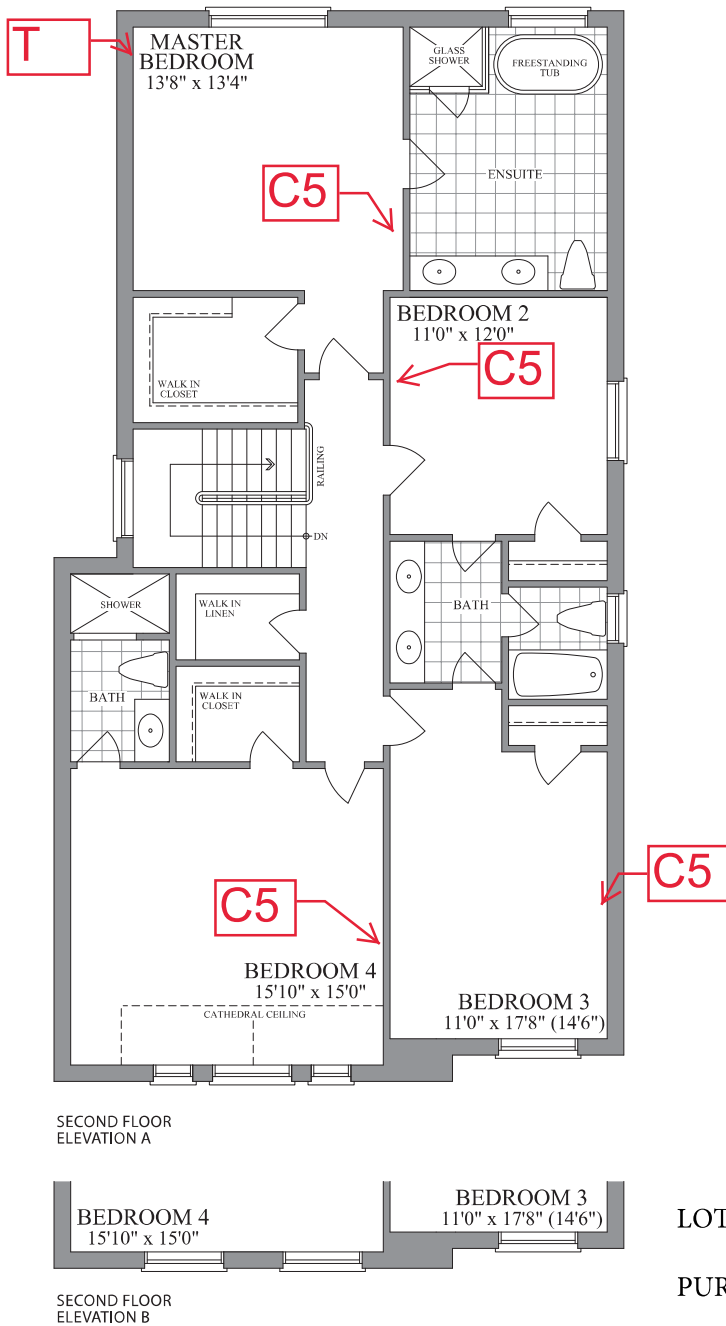


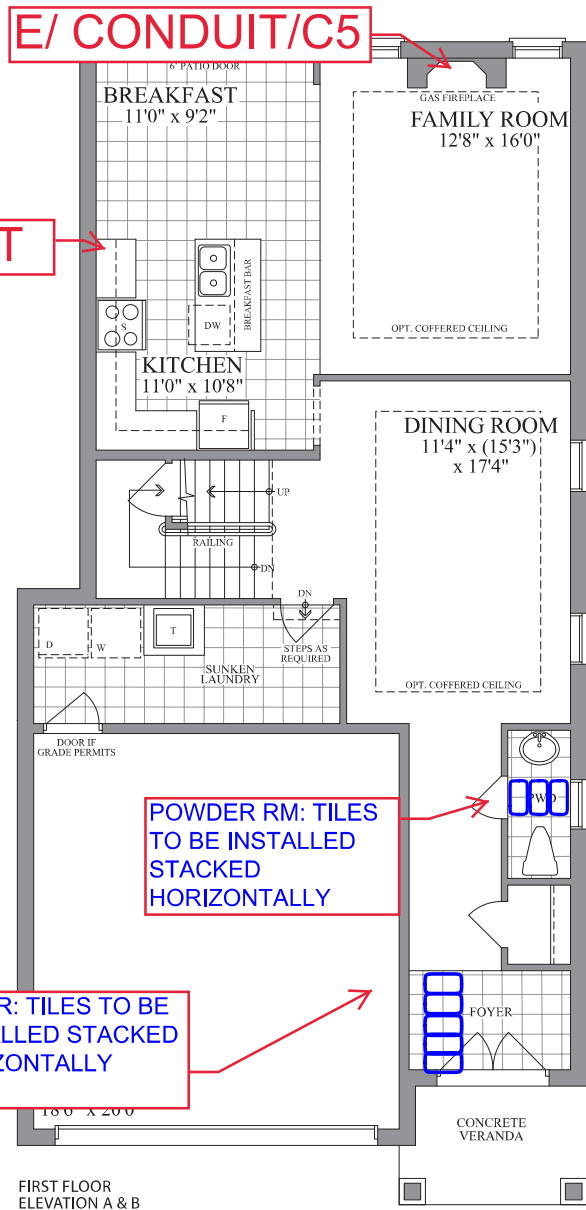

LOT #: **LOT 5-30, INNISFIL, PE005**

PURCHASER: RQ

PURCHASER: FS