


38'
DESIGNS

The **manitou** / Elev. A & B
2480 sq.ft.

LOT 5-34, PH5, PE004, TILE

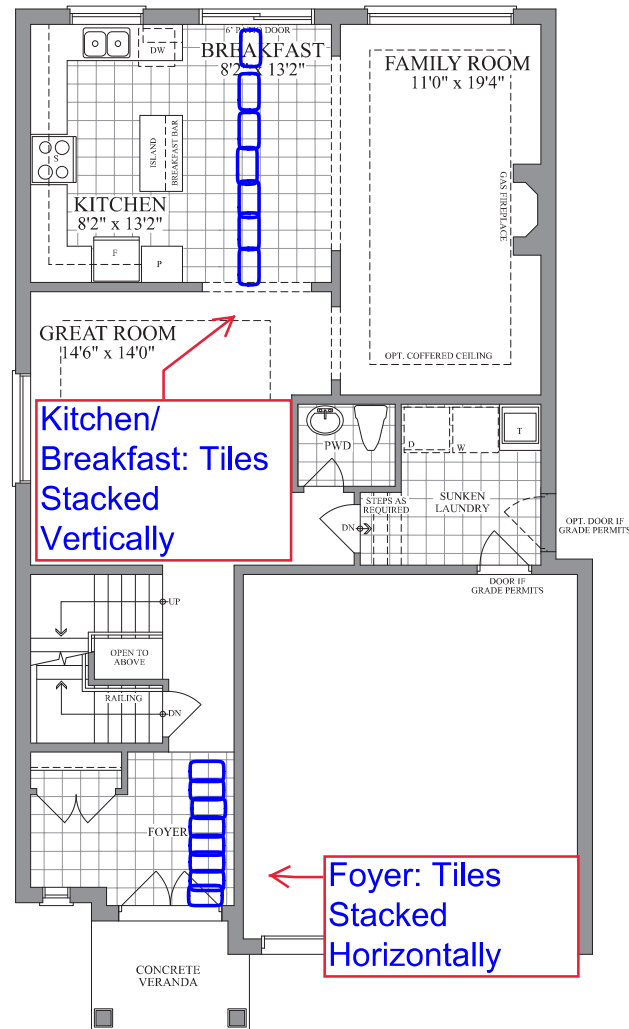

Purchaser's Initial(s): JS dk
Hiu

