


LOT 5-32, PH5, PE003

38'
DESIGNS


The Finlay / Elev. A & B
2515 sq.ft.

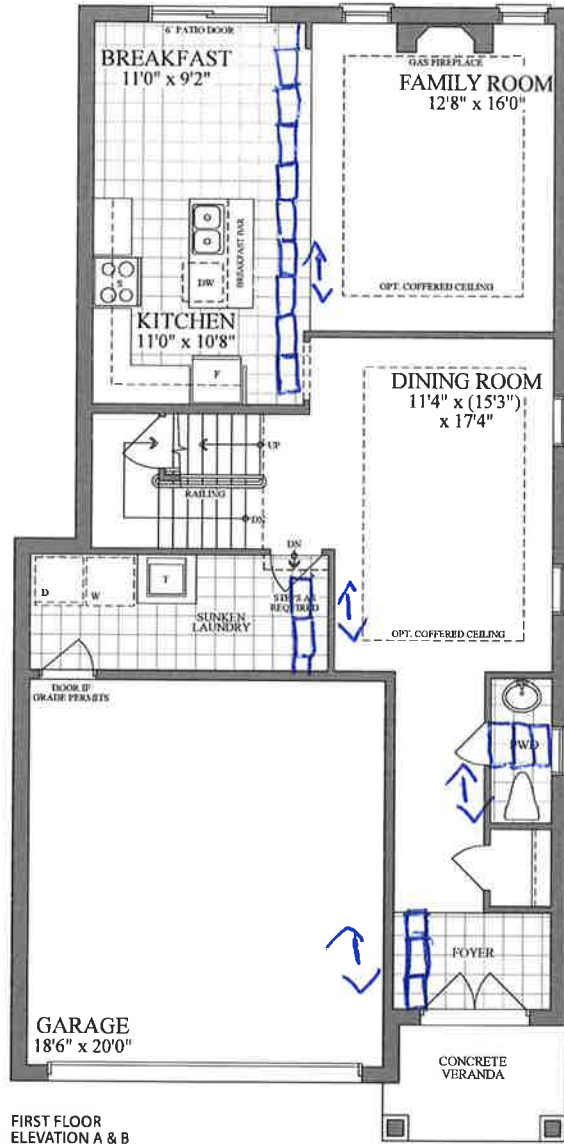

SECOND FLOOR
ELEVATION A



SECOND FLOOR
ELEVATION B

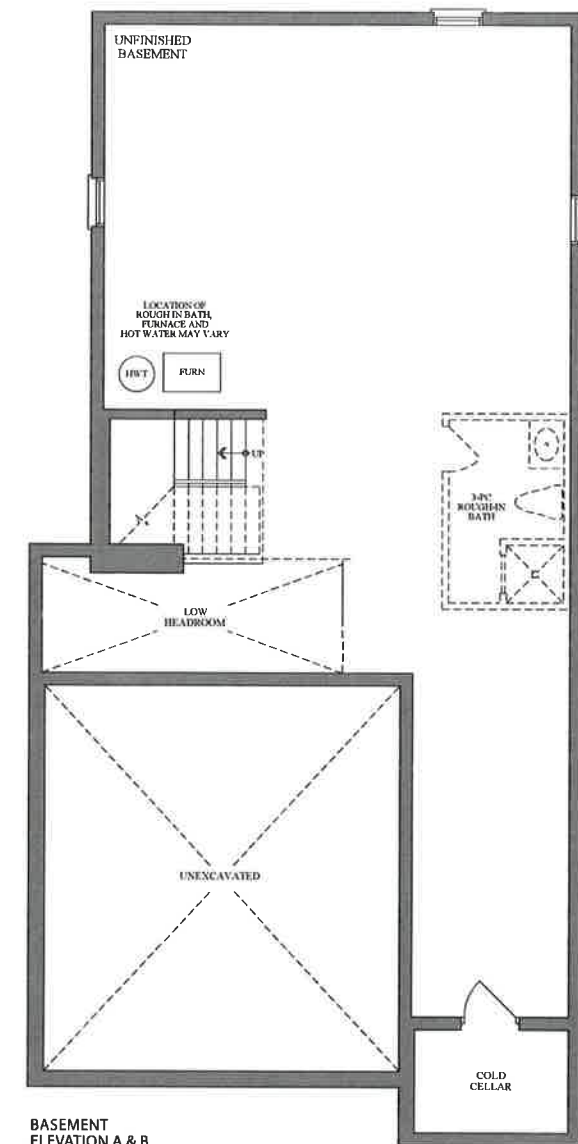

Plans and specifications are subject to change without notice. E. & O. E. Actual usable floor space may vary from the stated floor area. All renderings are artist's concept.