


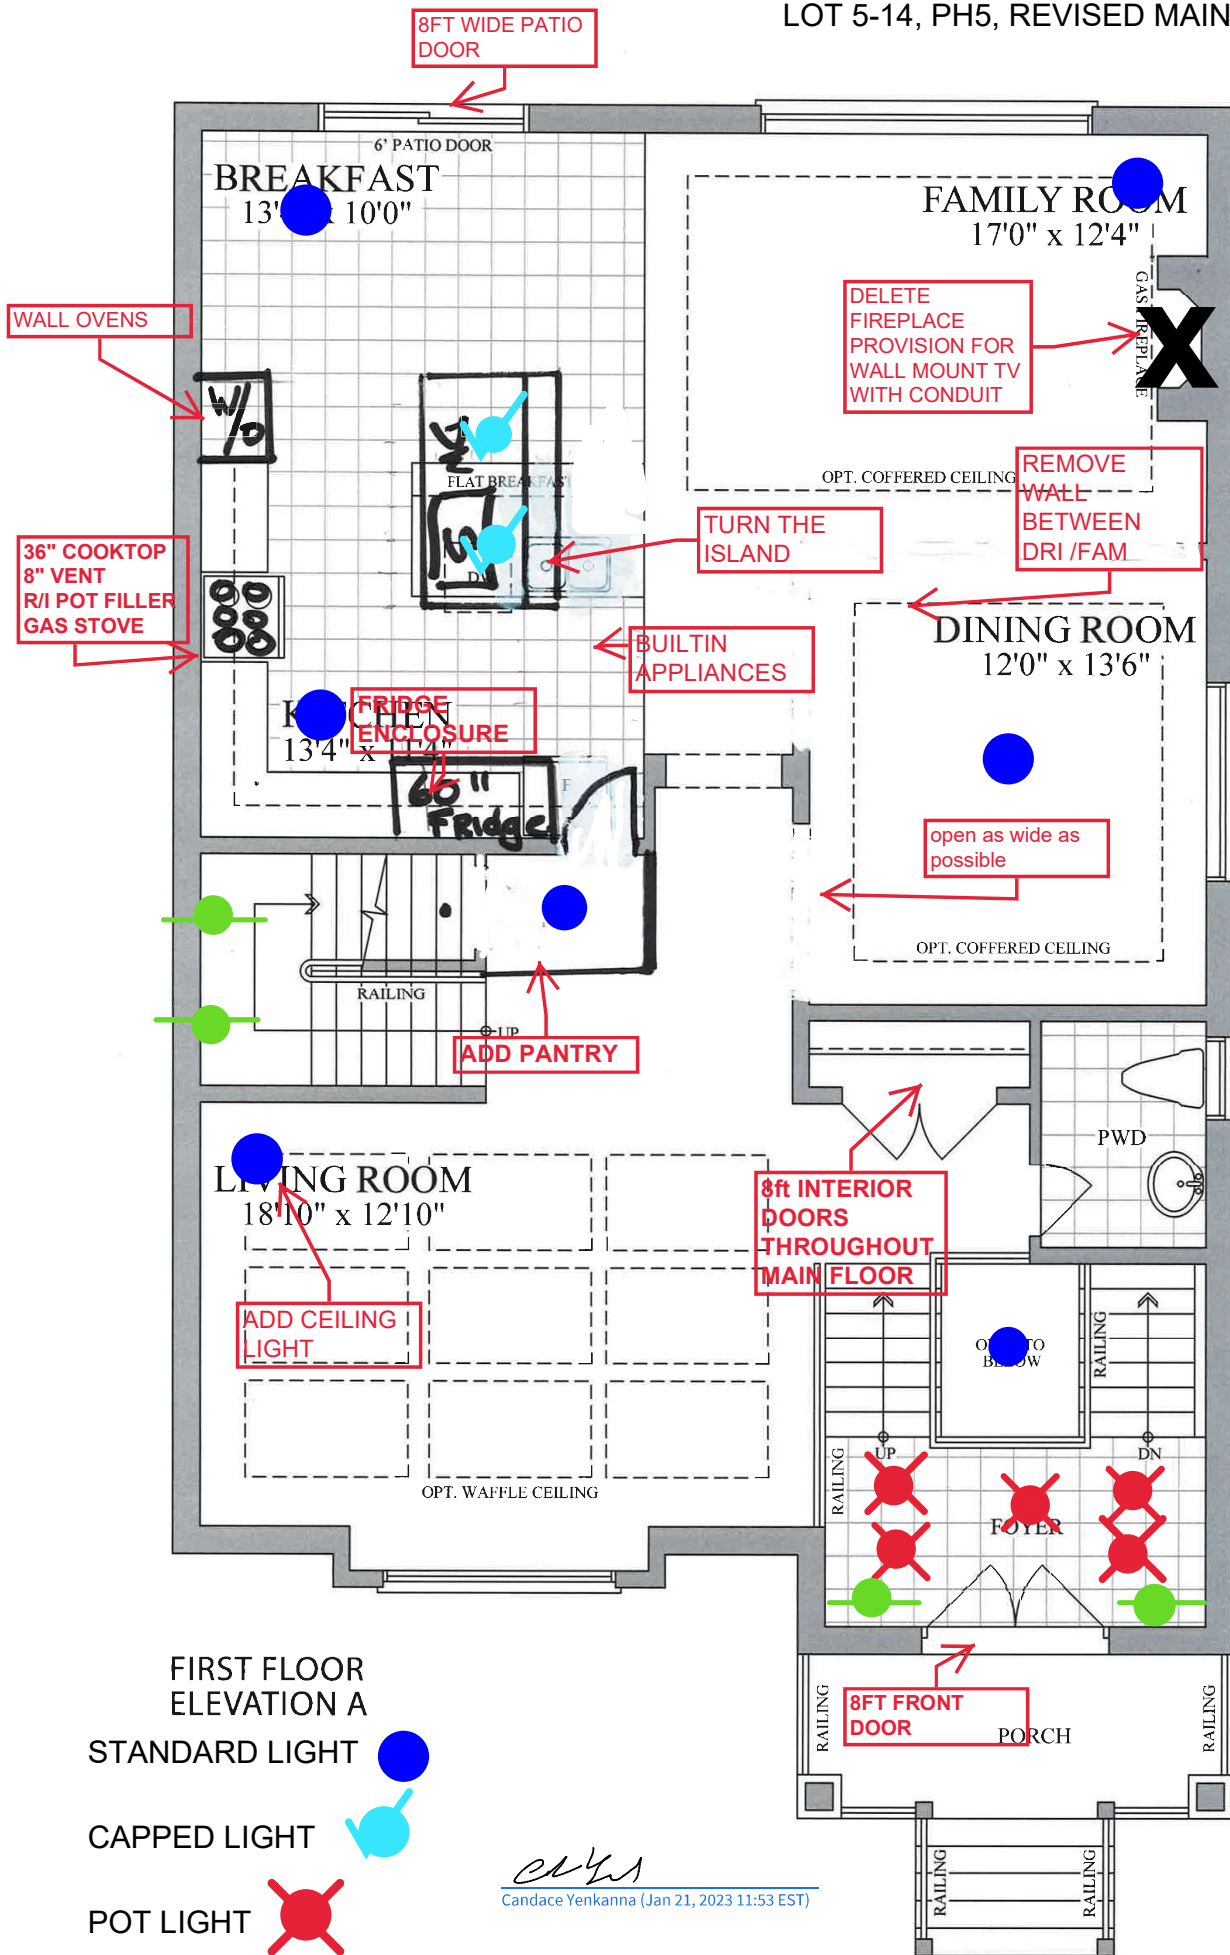

FIRST FLOOR
ELEVATION A

STANDARD LIGHT

CAPPED LIGHT


POT LIGHT

WALL SCNCE

Candace Yenkanha
Candace Yenkanha (Jan 21, 2023 11:53 EST)

charles yenkanha
charles yenkanha (Jan 21, 2023 02:12 EST)

LOT 5-14, PH5, REVISED 2ND FLOOR

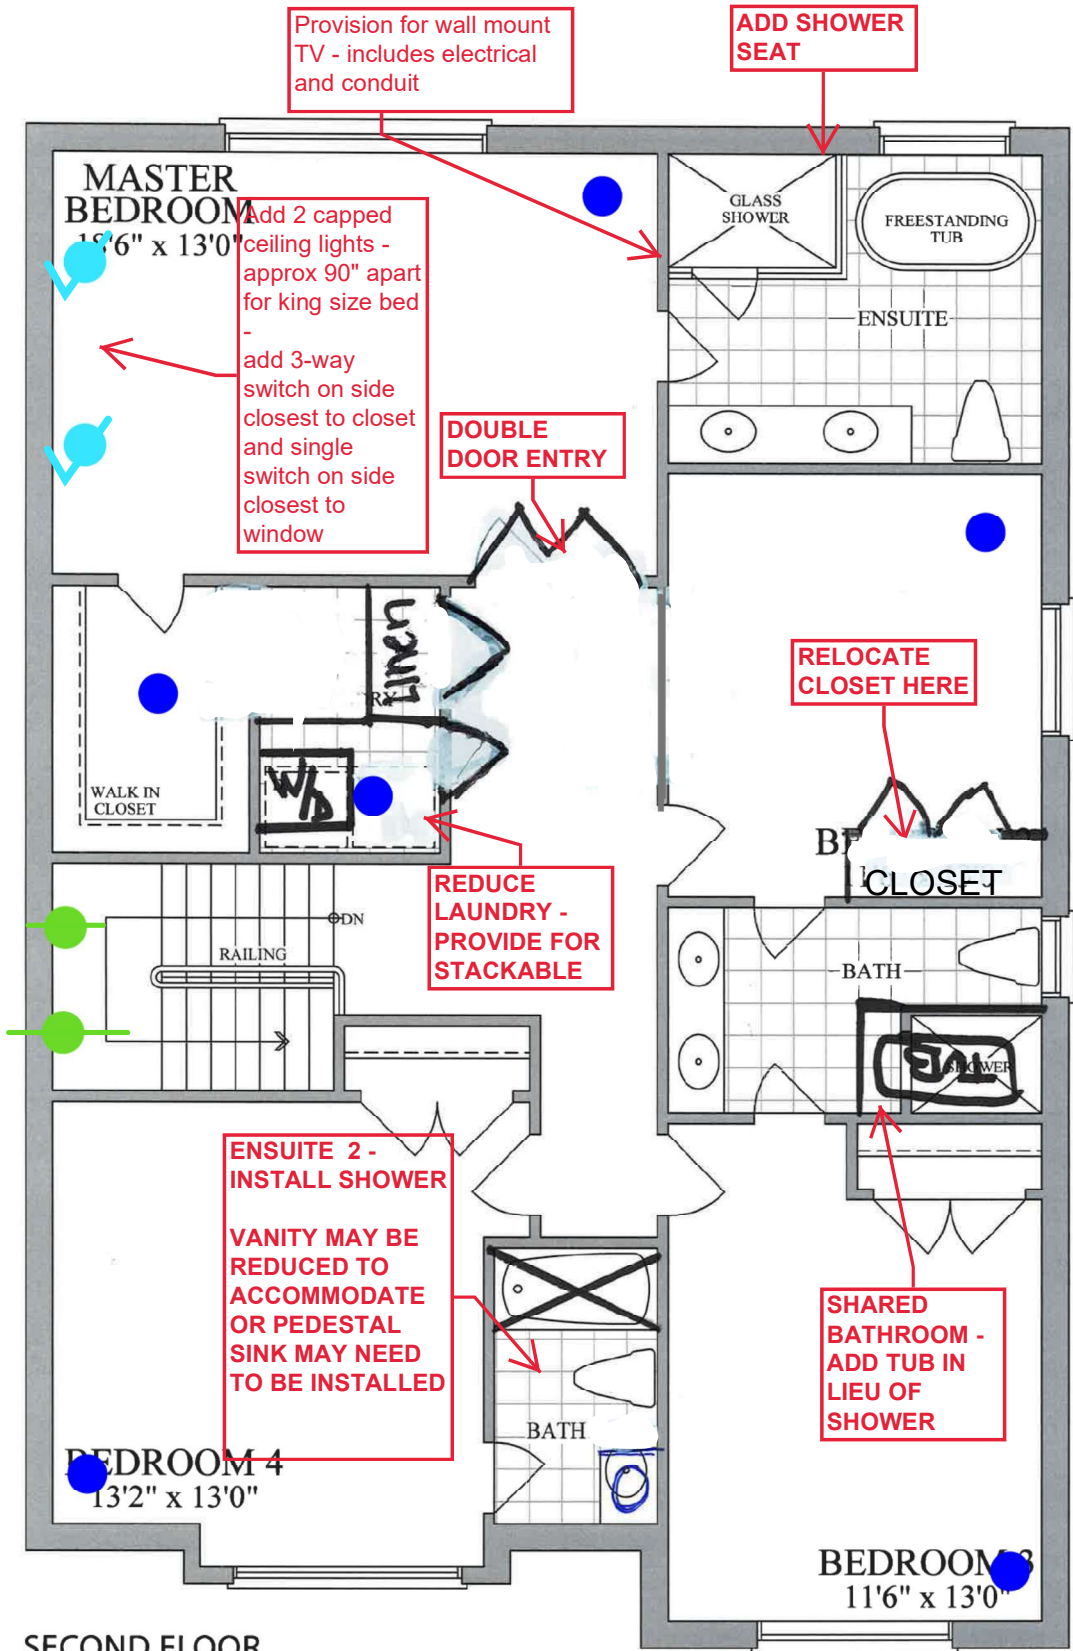


SECOND FLOOR
ELEVATION A

STANDARD LIGHT ●

CAPPED LIGHT ↗

WALL SCONSE —●—

POTLIGHT ✕

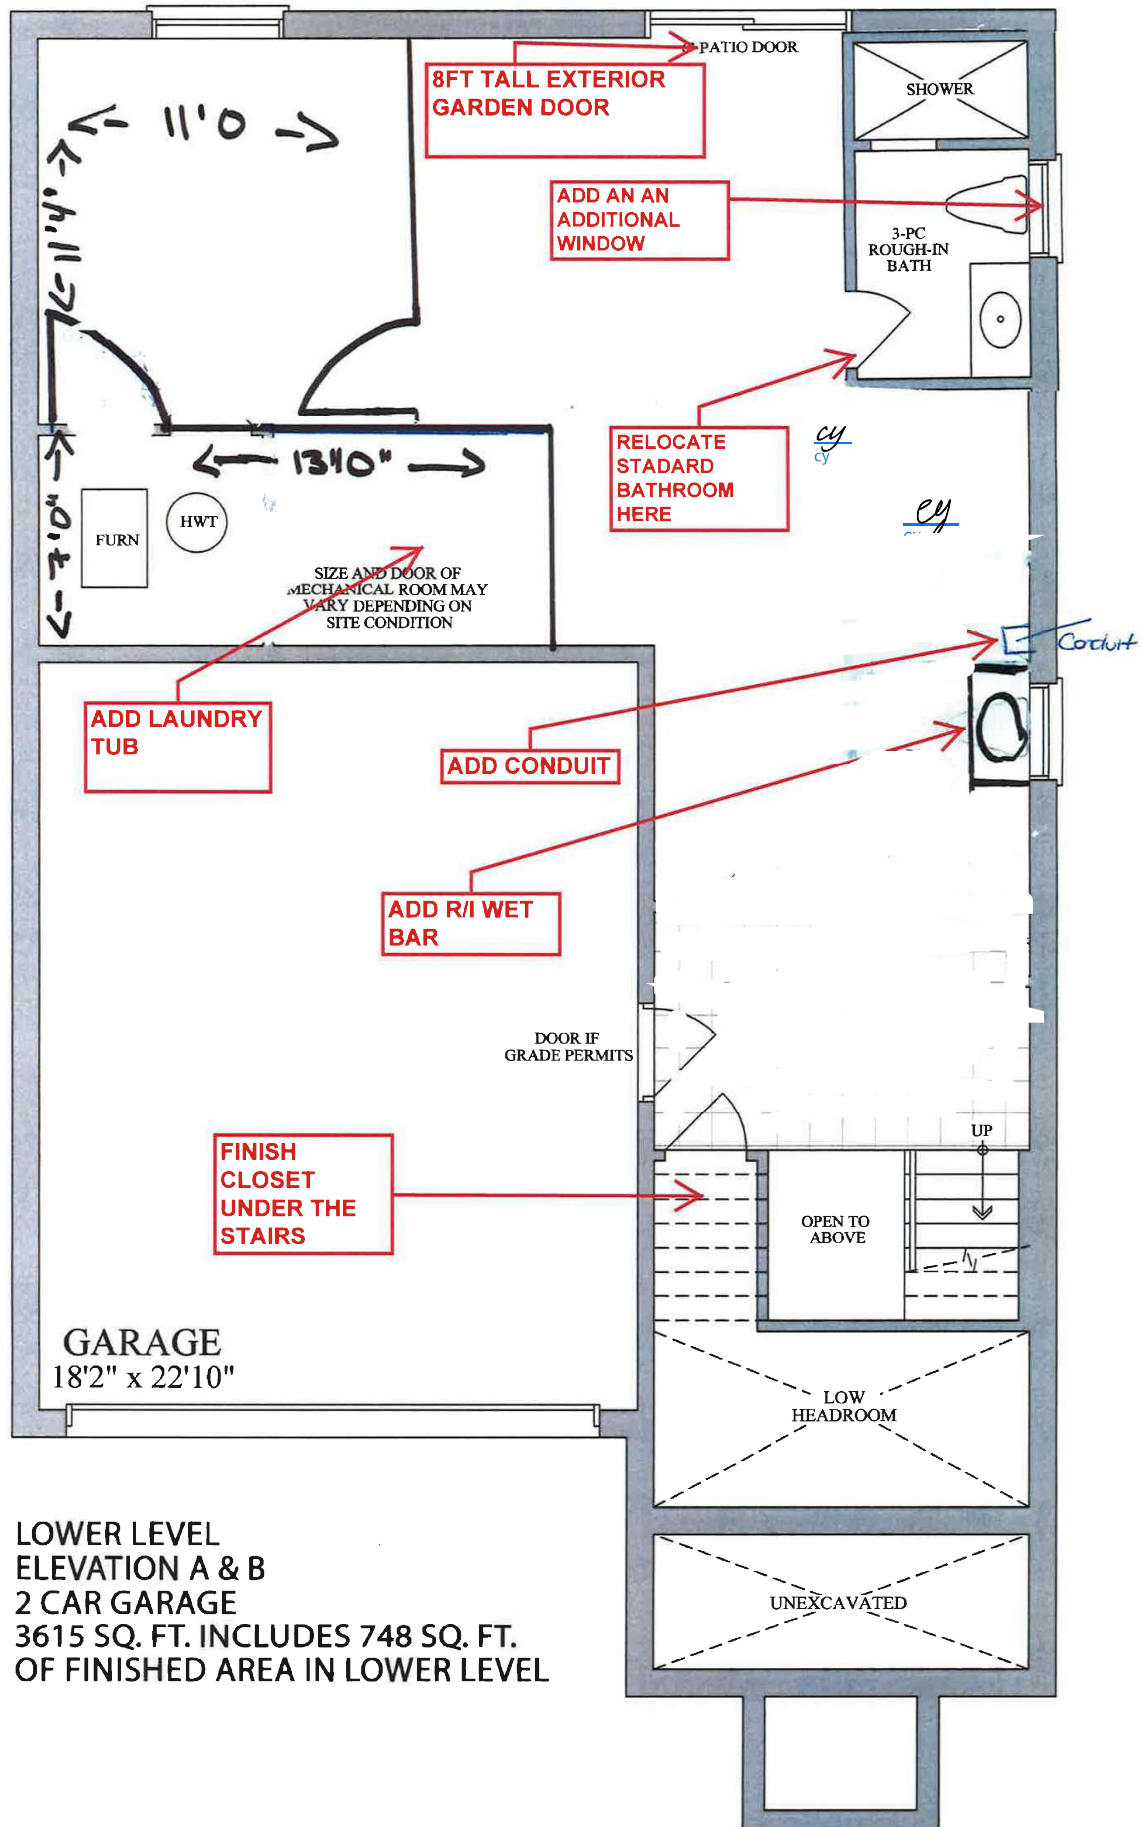

LOWER LEVEL
ELEVATION A & B
2 CAR GARAGE
3615 SQ. FT. INCLUDES 748 SQ. FT.
OF FINISHED AREA IN LOWER LEVEL

LOT 5-14, PH5, REVISED LOWER LEVEL

cy
Candace Yenkanna (Jan 21, 2023 11:53 EST)

charles yenkanna
charles yenkanna (Jan 21, 2023 02:12 EST)