



BELLAIRE PROPERTIES INC. (CARSON’S CREEK)  
PURCHASER EXTRAS

**LOT # 014 P.E #005** – Model - SUPERIOR - 3615 2 CAR - PHASE 5

Attention Trades...

The following items below are Purchaser Extras, please make sure that they are done on time and properly complete. Any outstanding items will be Back Charged. If you have any questions please call Roberto Ruiz. Make sure that you review ALL of the items on the Purchaser Extras.

Please be advised that Purchase Orders will come at a later date.

\*\*\*Also, it is very important to speak to Roberto Ruiz before starting on site \*\*

TRADE:	ITEMS TO BE COMPLETED
All-Tronic	#1

Date: Feb.-10-2023  
From: Lormel Homes  
Site Clerk: Jai Fitzgerald  
Site Tel: 905-775-3633  
Site Fax: 905-775-9083

**NOTE:** If more information is needed please call Roberto Ruiz cell-416-688-9324  
If more information needed on quotes or changes, please call Zachary 905-832-2023 ext. 224



**forming part of the Agreement of Purchase and Sale**

**BELLAIRE PROPERTIES INC.**

**P.E.#: 005**


[illegible]

• The Vendor will undertake to install the above extras but will not be liable to the purchaser if for any reason the work covered by the extra is not carried out. In that event, the price of the extra shall be refunded to the purchaser without any interest.

• It is understood and agreed that if the transaction of Purchase and Sale is not completed for any reason whatsoever, the total cost of all extra is not refundable.

PURCHASER

(Original verified at Head Office)

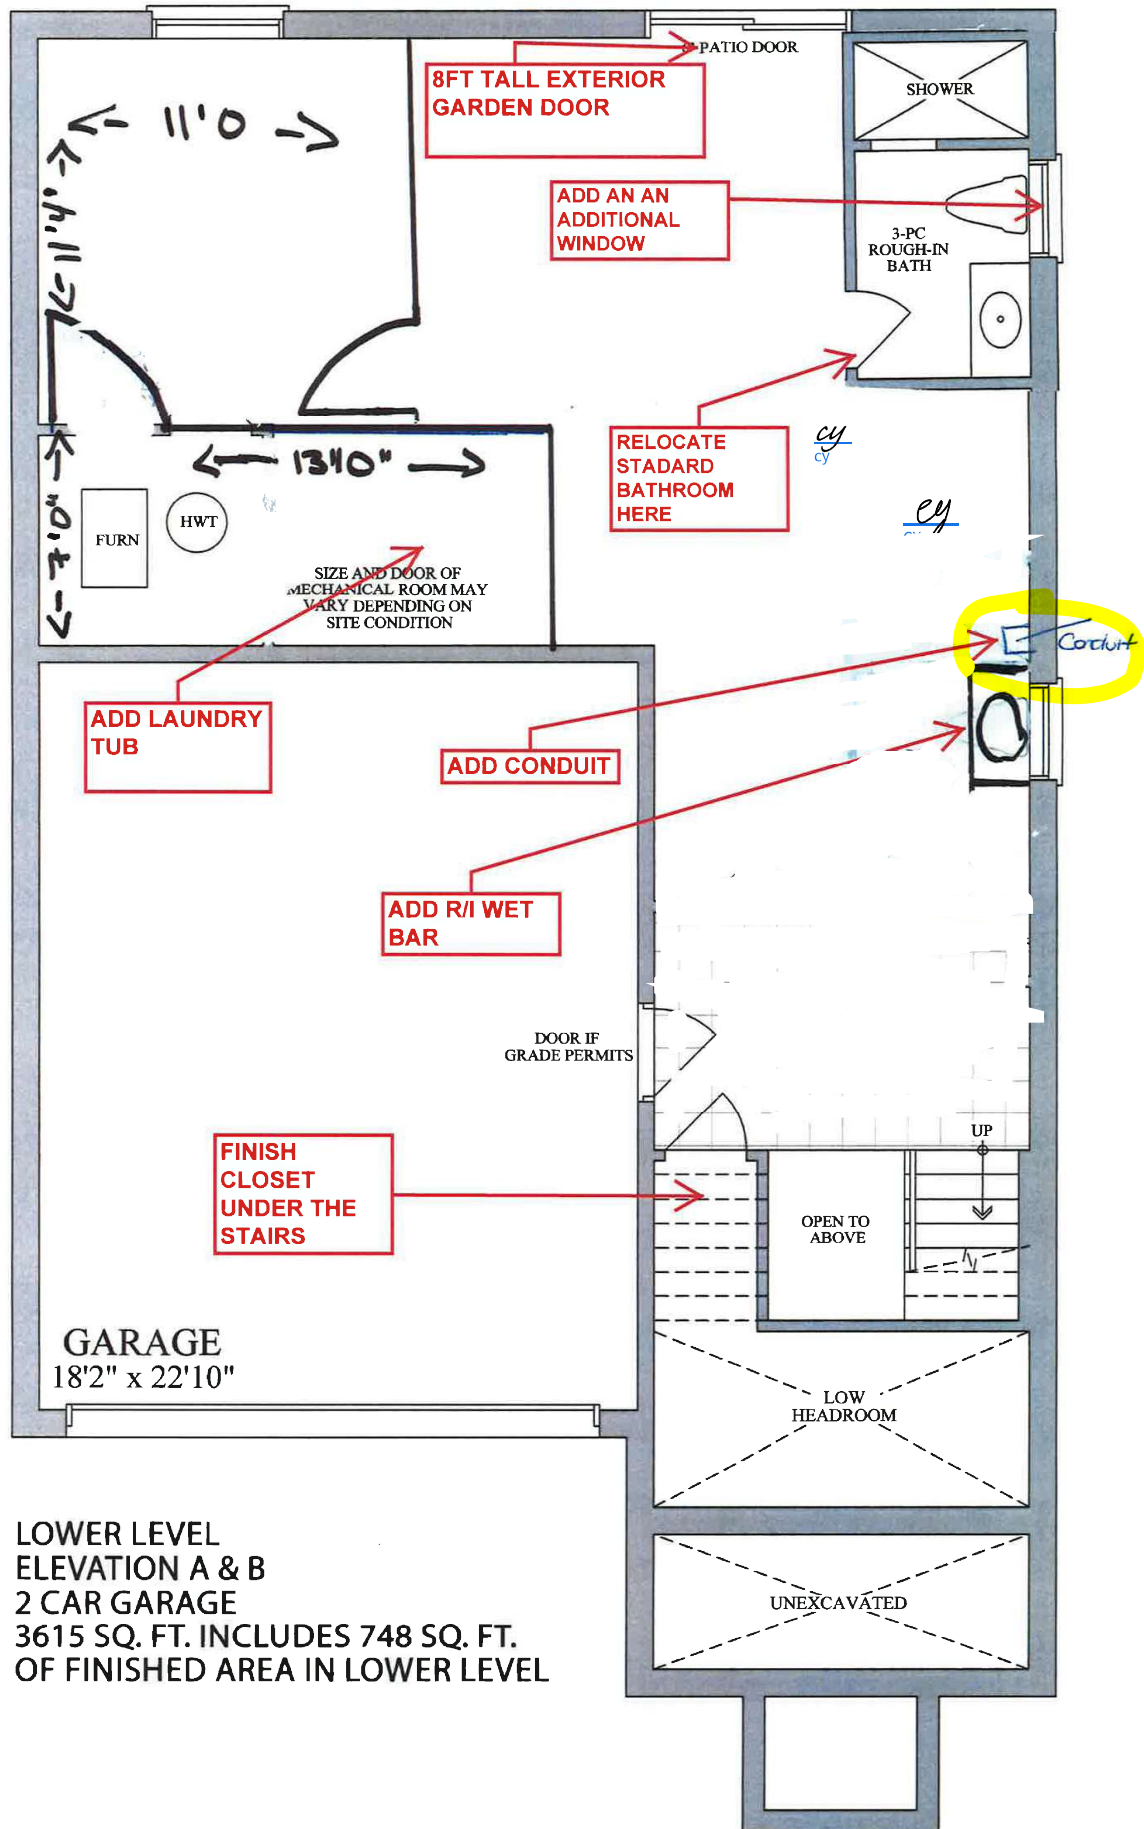

LOWER LEVEL  
ELEVATION A & B  
2 CAR GARAGE  
3615 SQ. FT. INCLUDES 748 SQ. FT.  
OF FINISHED AREA IN LOWER LEVEL

LOT 5-14, PH5, REVISED LOWER LEVEL

*Charles Yenkanna*  
Candace Yenkanna (Jan 21, 2023 11:53 EST)

*Charles Yenkanna*  
charles.yenkanna (Jan 21, 2023 02:12 EST)