

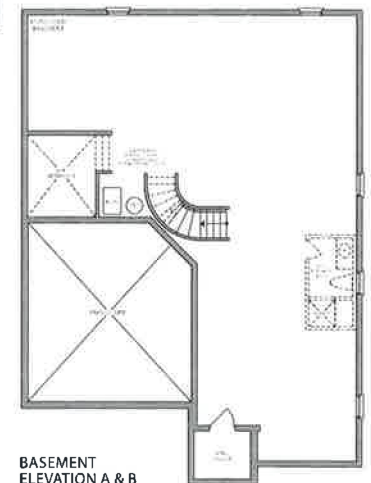
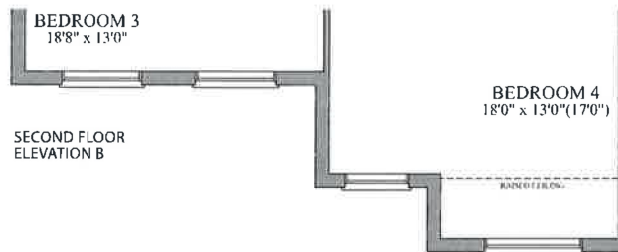


Purchaser's Signature(s): Sabina Luna (Feb 21, 2023 18:41 EST)

The **nipissing** / Elev. A & B
3210 sq.ft.

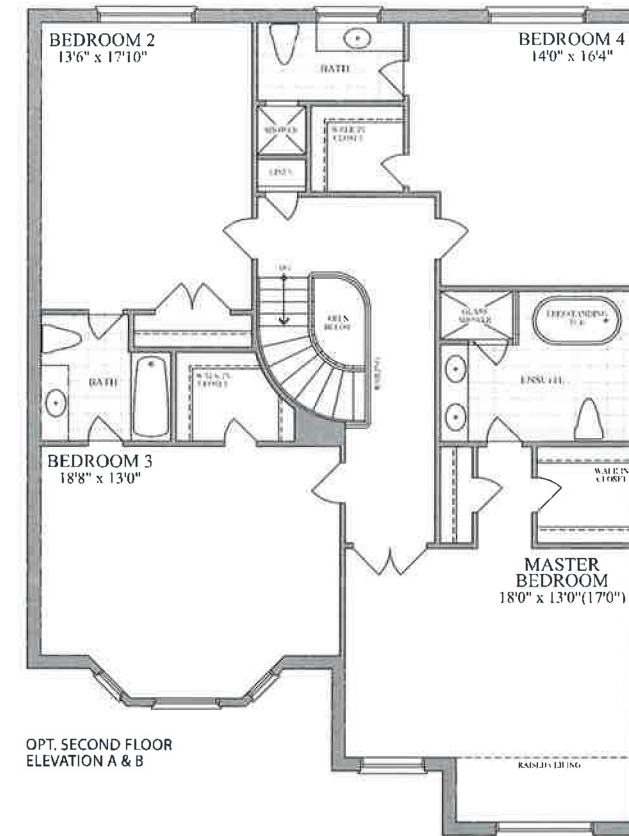

LOT 5-91 PE002: SabinaAltafLuna
PURCHASER: SabinaAltafLuna (May 17, 2022 20:29 EDT)

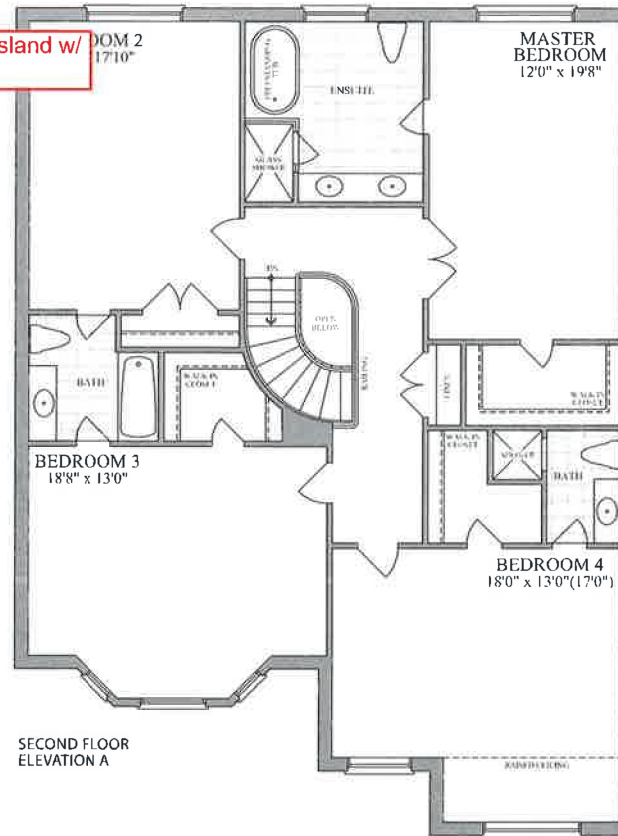

Plans and specifications are subject to change without notice. E. & O. E. Actual usable floor space may vary from the stated floor area. All renderings are artist's concept.