





LOT 5-31, PH5, PE004, SKETCH

38'
DESIGNS

The manitou / Elev. A & B
2480 sq.ft.

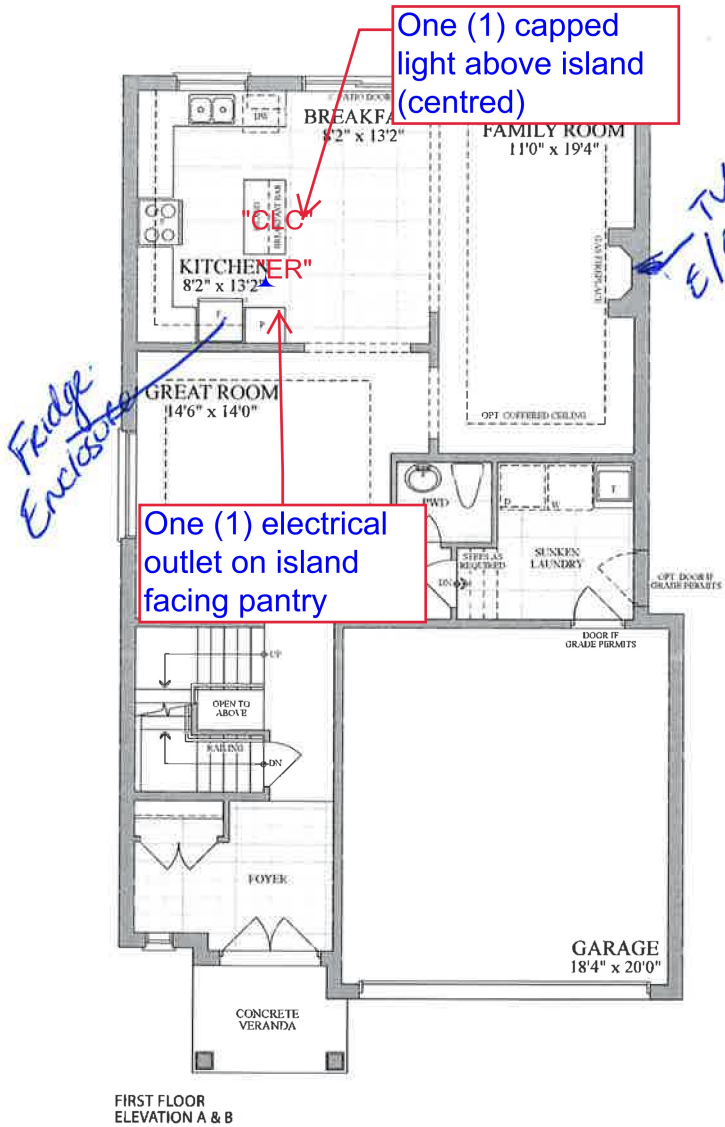

Purchaser's Initial(s): BOI

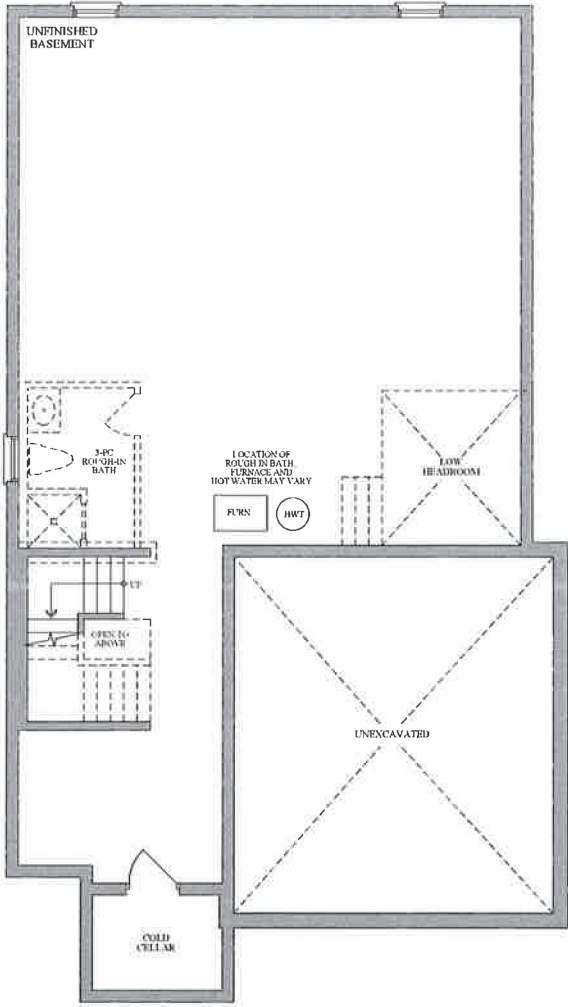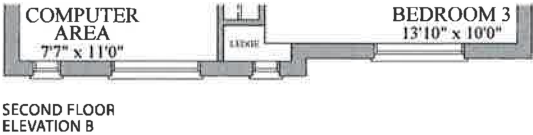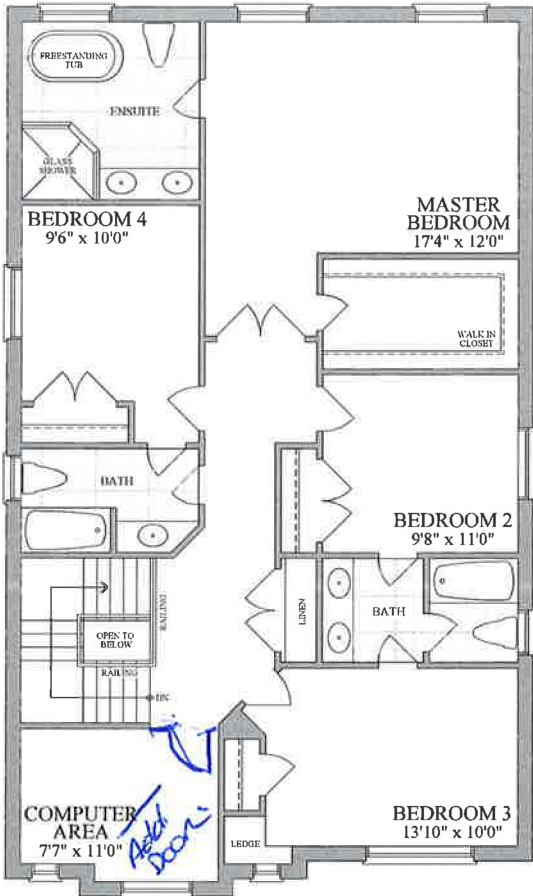

Plans and specifications are subject to change without notice. E. & O. E. Actual usable floor space may vary from the stated floor area. All renderings are artist's concept.

~~LOT 5-31, PH5, PE004, SKETCH~~
~~04.21.22~~