
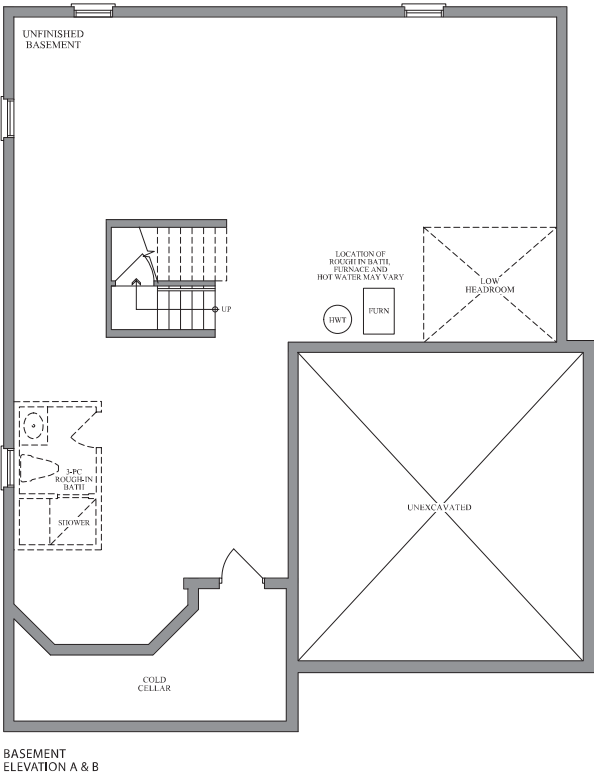
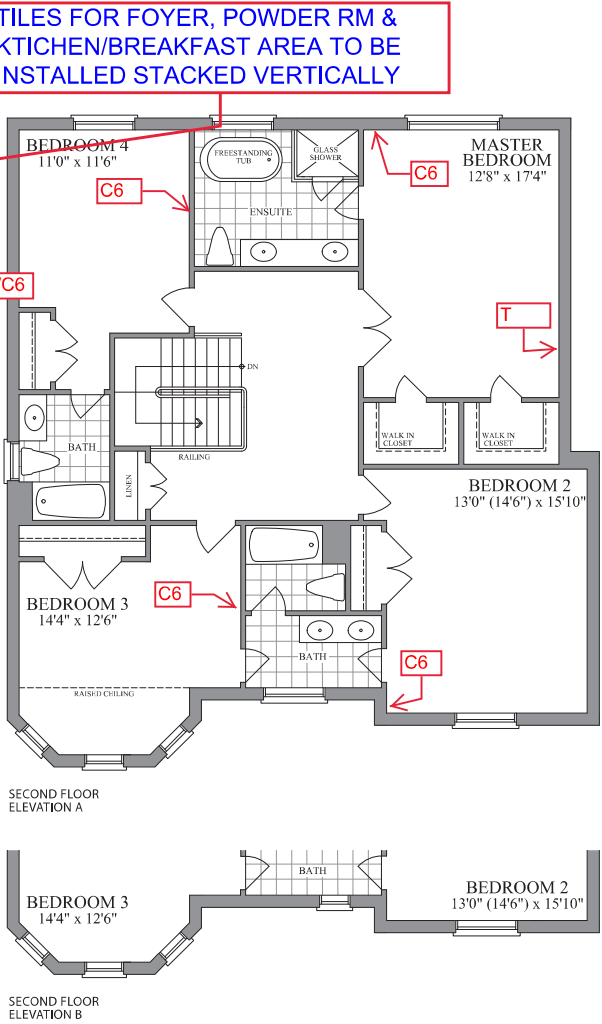


LOT 5-28, PH5, PE005, SKETCH

Purchaser's Initial(s): PS BBS

47' DESIGNS
The Arrowhead / Elev. A & B
2650 sq.ft.

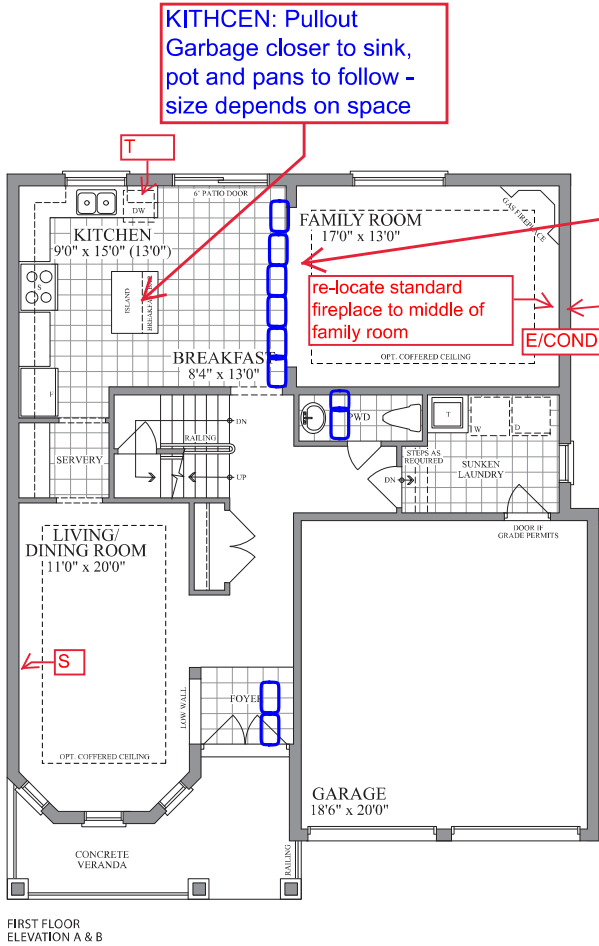

~~LOT 5-28, PH5, PE005~~

PURCHASER: Pranay Sharma (Jun 10, 2022 18:54 EDT)

PURCHASER: Buyer: Pranay Sharma (Jun 10, 2022 18:54 EDT)



Plans and specifications are subject to change without notice. E, & O, E. Actual usable floor space may vary from the stated floor area. All renderings are artist's concept.