



47'
DESIGNS


The nipping / Elev. A & B
3210 sq.ft.

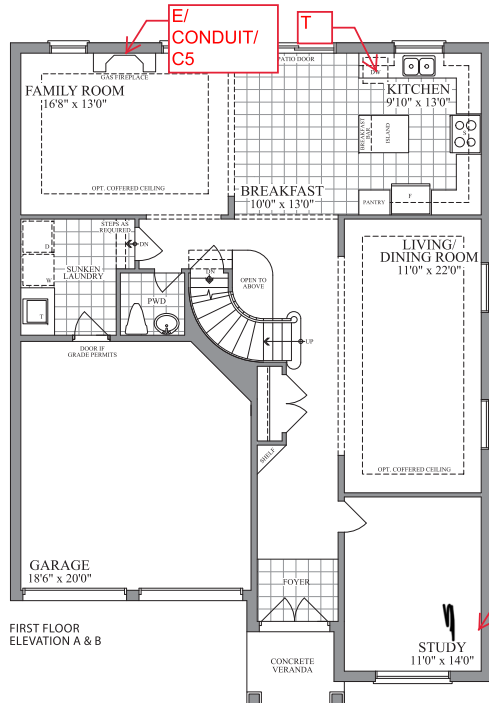


FIRST FLOOR
ELEVATION A & B

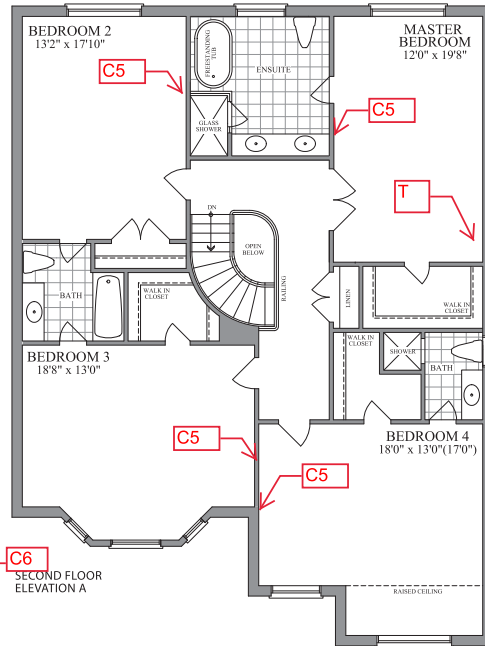


SECOND FLOOR
ELEVATION A

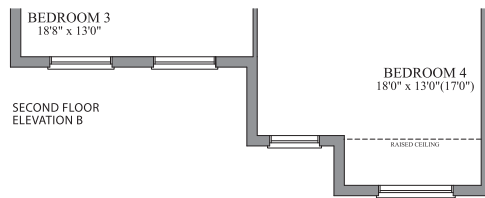

SECOND FLOOR
ELEVATION B

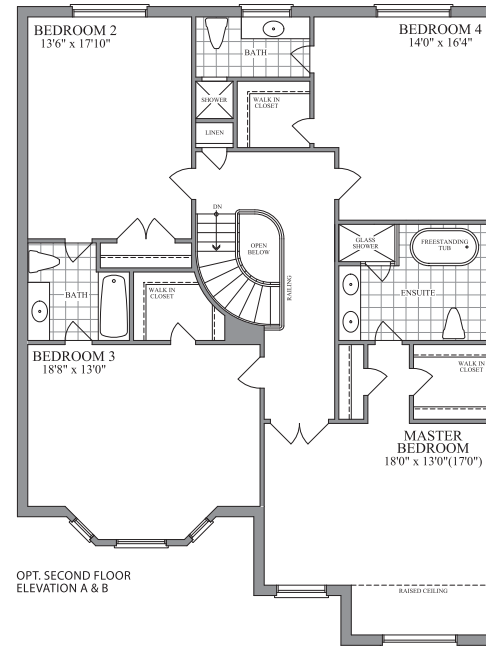

OPT. SECOND FLOOR
ELEVATION A & B

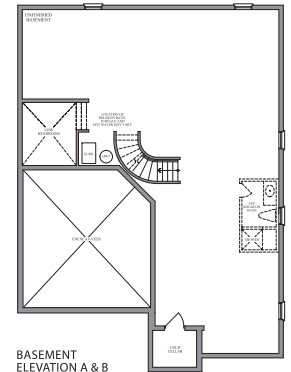

BASEMENT
ELEVATION A & B

Please indicate the location of the rough-ins on your plan

Description	Symbol on Sketch	Standard Locations
Cable (Rough-in)	C	Family room Or Great Room, all bedrooms, Study/Den/Computer, (as per model)
Cat5	C5	A Cat5 wire can replace the rough-in cable at no additional cost.
Cat6	C6	Upgrade - \$50 per location
Telephone (Rough-in)	T	Kitchen and Primary Ensuite
Smart-Wire (Cat5)	S	Can be installed a Purchaser's desired location

Plans and specifications are subject to change without notice. E. & O. E. Actual usable floor space may vary from the stated floor area. All renderings are artist's concept.



LOT 5-27
#

PURCHASER: Narinderpal S Thind (Mar 18, 2023 14:28 EDT)

PURCHASER: Jaswant kaur Thind (Mar 15, 2023 14:22 EDT)

