
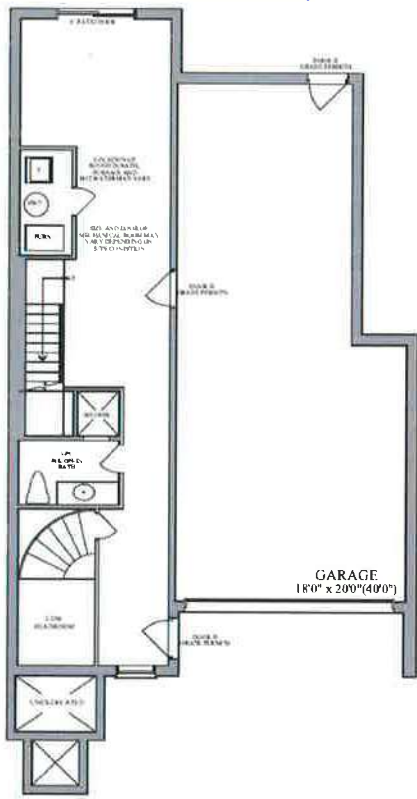
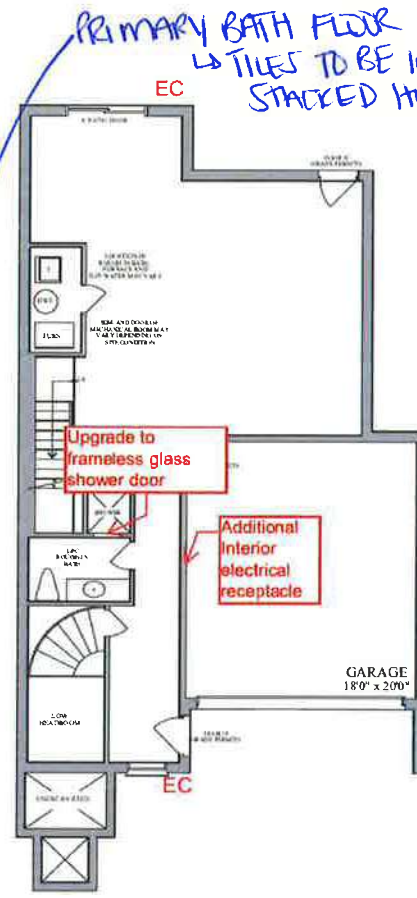


LOT 5-07, PH5, PE005, SKETCH

Purchaser's Initial(s): R.F. CR RS

38'
DESIGNS

the Temagami / Elev. A & B
2 Car Garage 3350 sq. ft. - includes 760 sq. ft. of finished area in lower level

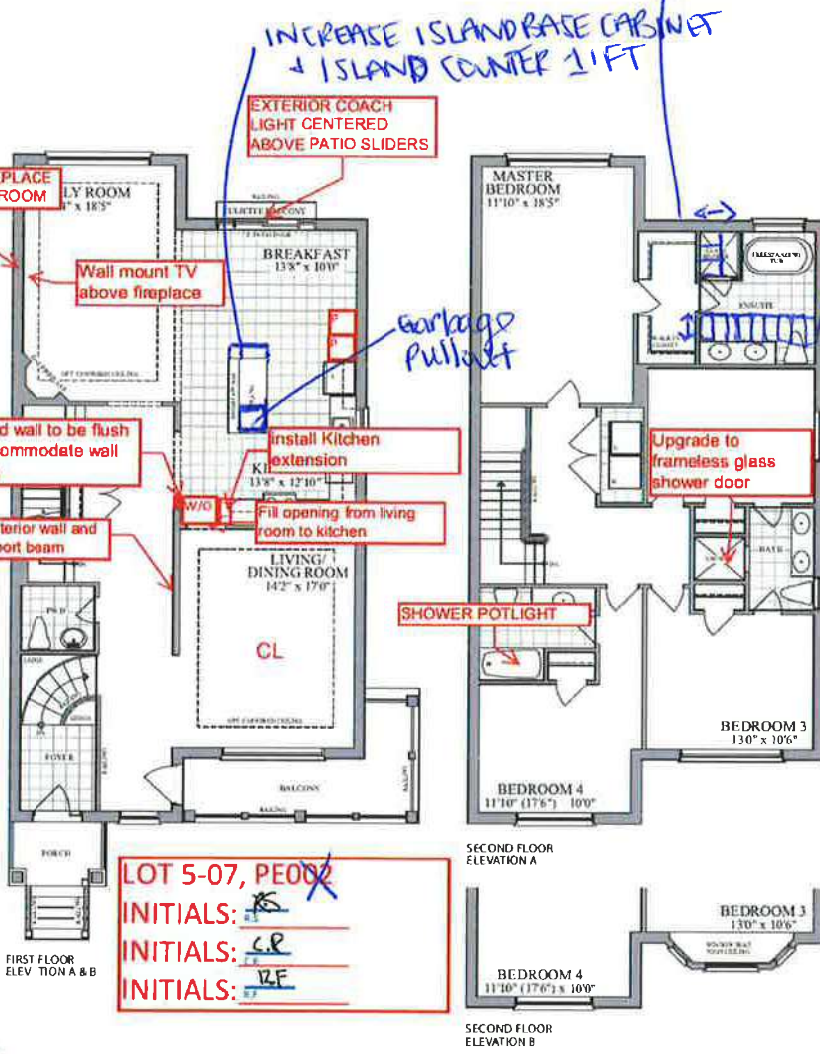

Signature: Rochelle shepherd (Mar 28, 2023 21:12 EDT)
Email: rochelle.shepherd@hotmail.com