



LOT # 010 P.E #004 – Model - BUCKHORN - 1800 - PHASE 5

The following items below are Purchaser Extras, please make sure that they are done on time and properly complete. Any outstanding items will be Back Charged. If you have any questions please call Roberto Ruiz. Make sure that you review ALL of the items on the Purchaser Extras.

*****Also, it is very important to speak to Roberto Ruiz before starting on site ****




Date: April 11, 2023
From: Lormel Homes
Site Clerk: Jai Fitzgerald
Site Tel: 905-775-3633
Site Fax: 905-775-9083

NOTE: If more information is needed please call Roberto Ruiz cell-416-688-9324
If more information needed on quotes or changes, please call Zachary 905-832-2023 ext. 224

38'
DESIGNS

The Buckhorn / Elev. A & B
1800 sq.ft.

Purchaser's Initial(s): S.T. T.J.

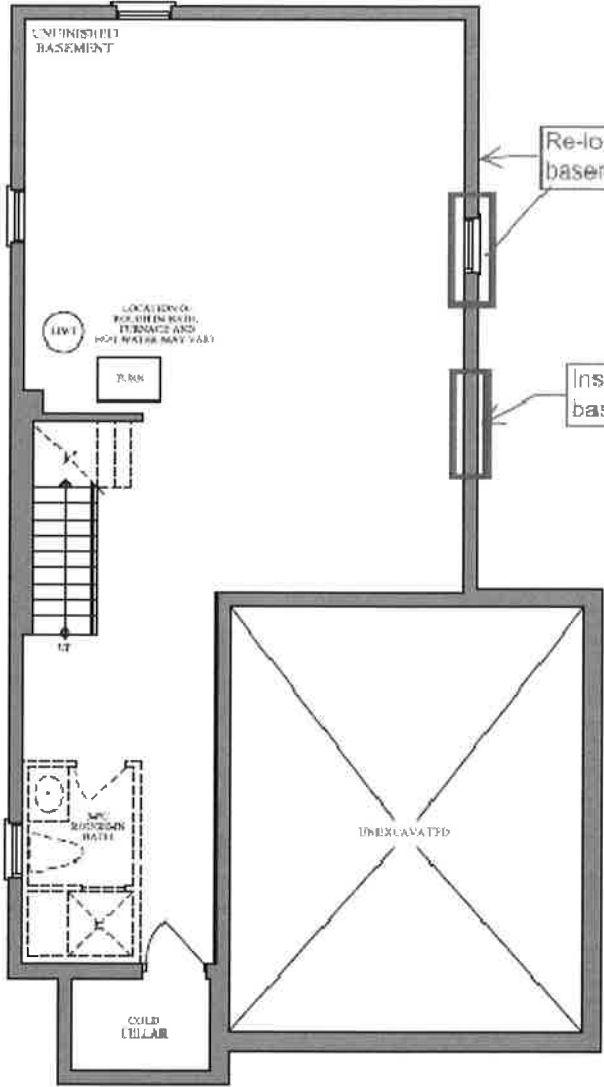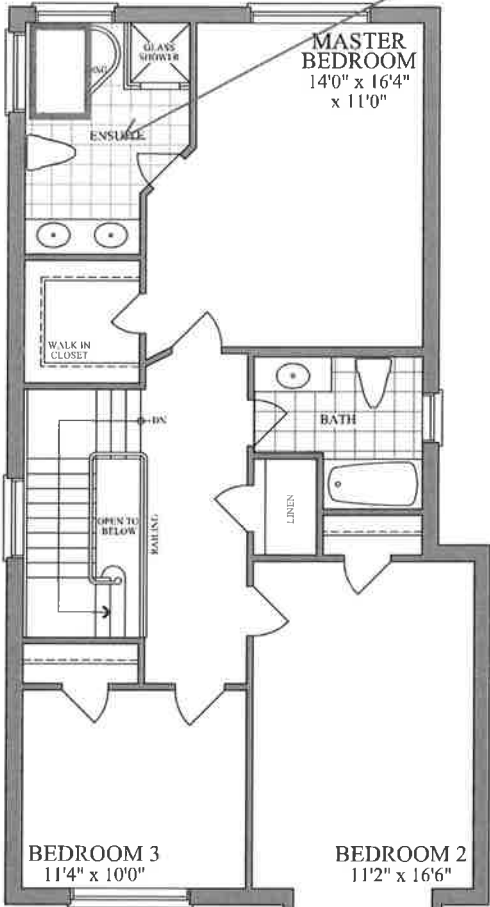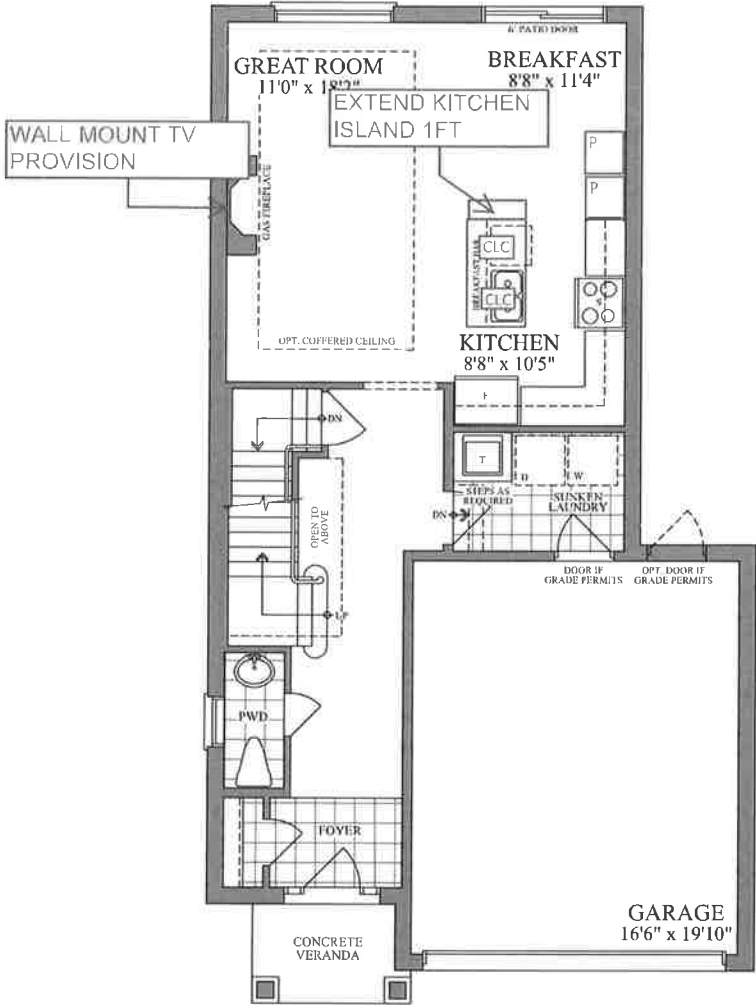

PURCHASER: Tony (Jun 27, 2022 23:16 EDT)

PURCHASER: Smitha Thomas (Jun 27, 2022 23:33 EDT)



Plans and specifications are subject to change without notice, E, & O, E. Actual usable floor space may vary from the stated floor area. All renderings are artist's concept.