
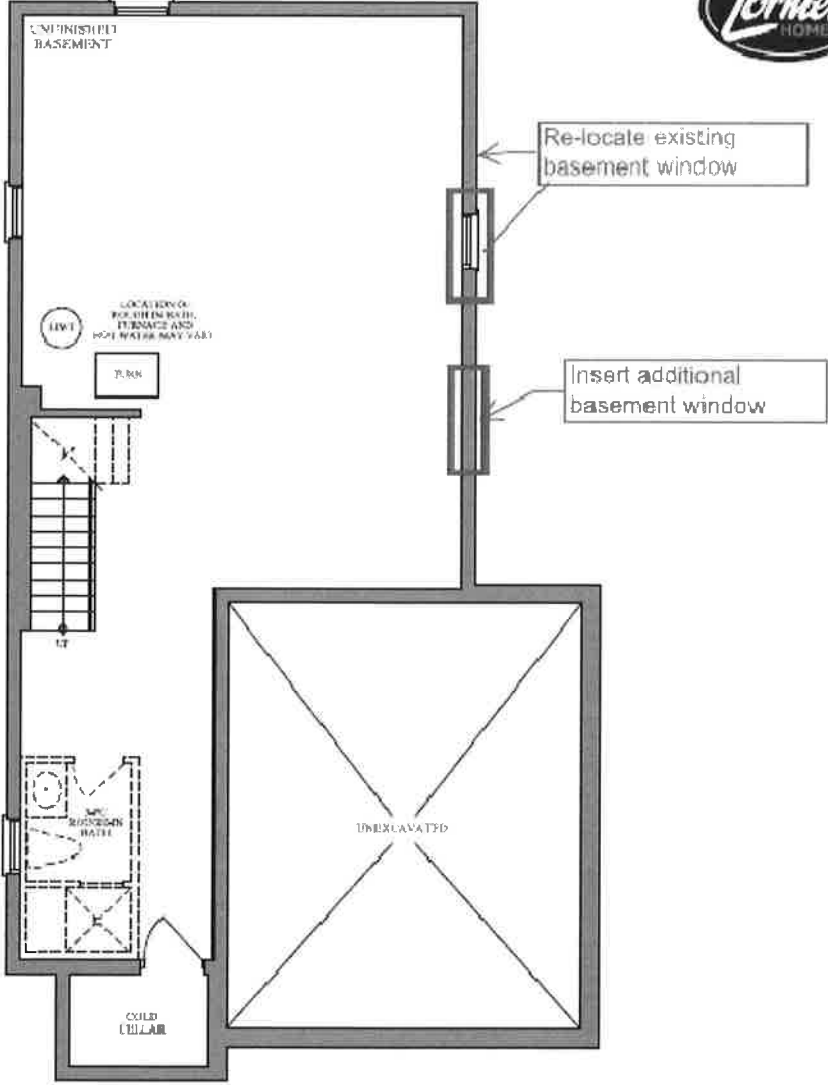
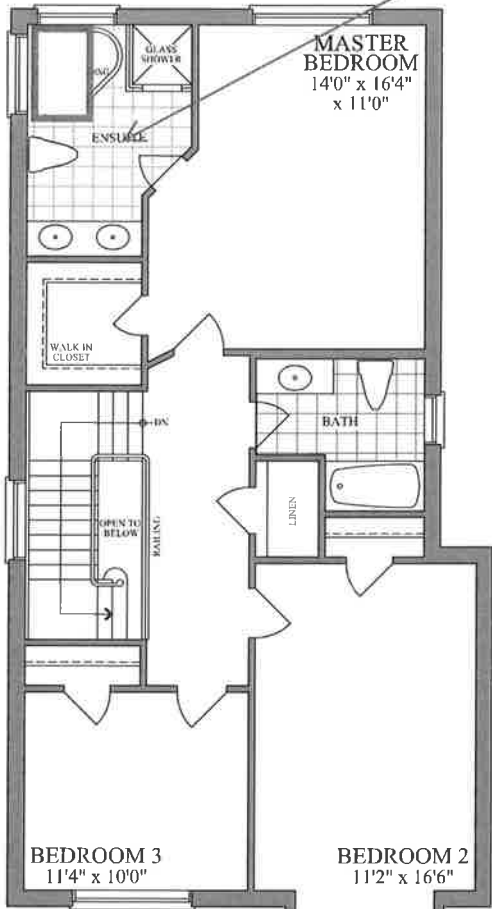


38'
DESIGNS

The Buckhorn / Elev. A & B
1800 sq.ft.

Purchaser's Initial(s): S.T. T.J.

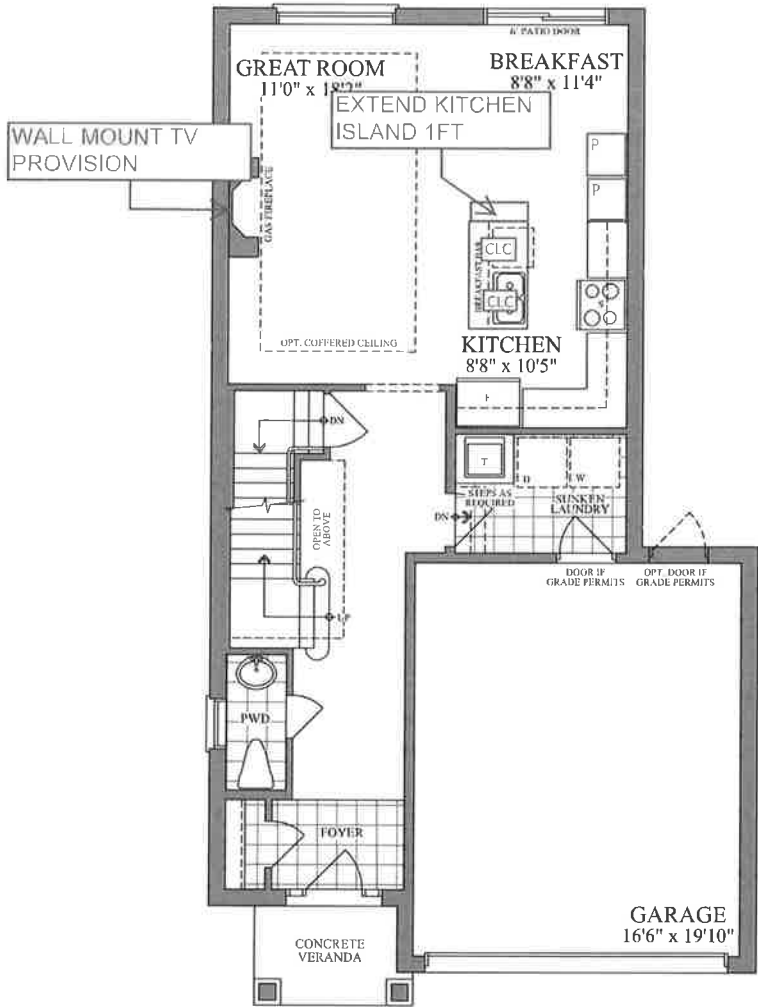

Plans and specifications are subject to change without notice, E, & O, E. Actual usable floor space may vary from the stated floor area. All renderings are artist's concept.

PURCHASER: Tony (Jun 27, 2022 23:16 EDT)
PURCHASER: Smitha Thomas (Jun 27, 2022 23:33 EDT)