



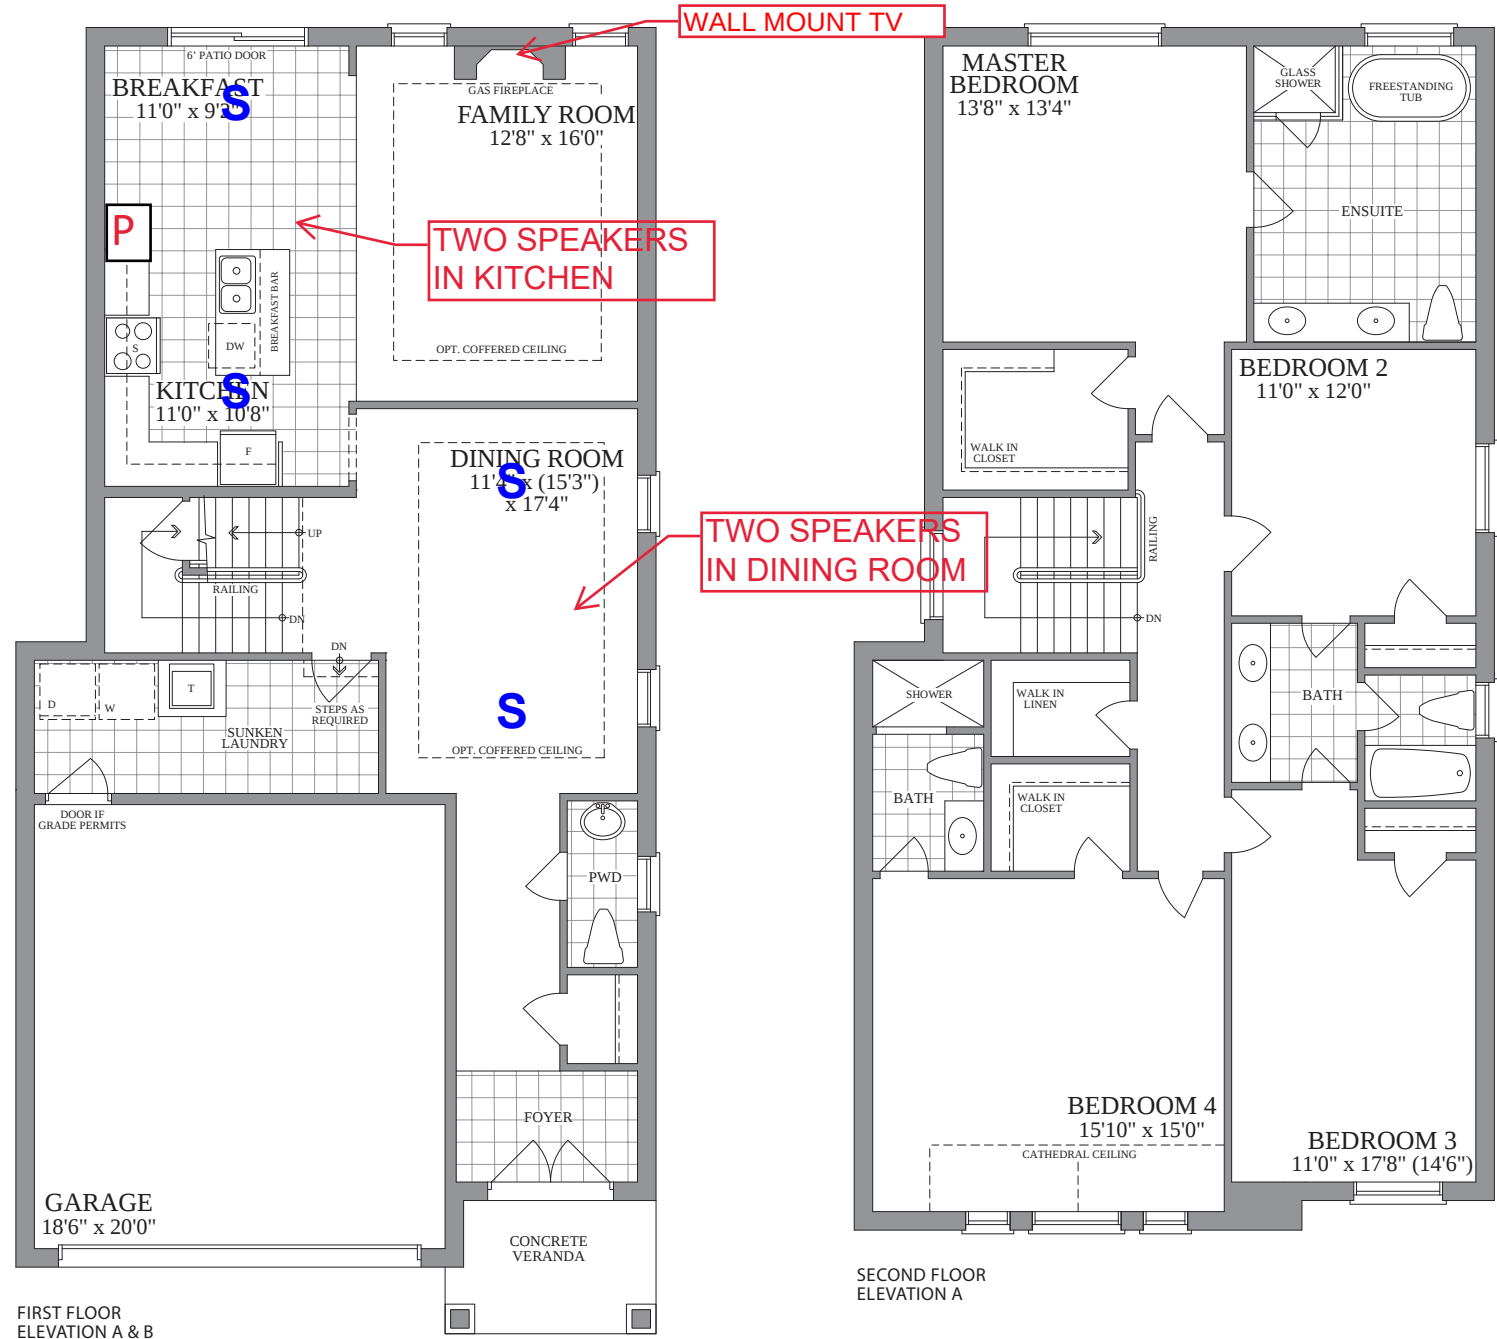


FIRST FLOOR
ELEVATION A & B

SECOND FLOOR
ELEVATION A

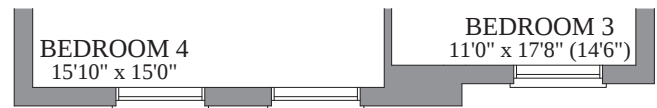

SECOND FLOOR
ELEVATION B

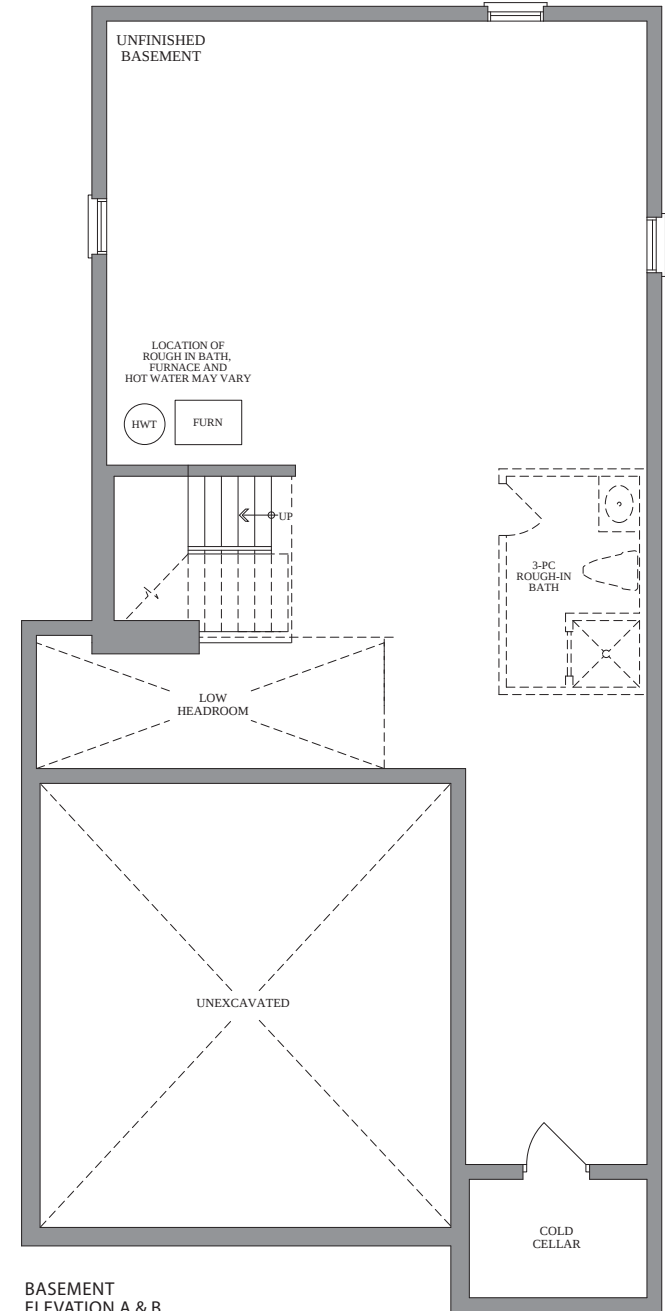

BASEMENT
ELEVATION A & B

LOT 5-36- PE002

PURCHASER: _____