


SECOND FLOOR  
ELEVATION A



SECOND FLOOR  
ELEVATION B

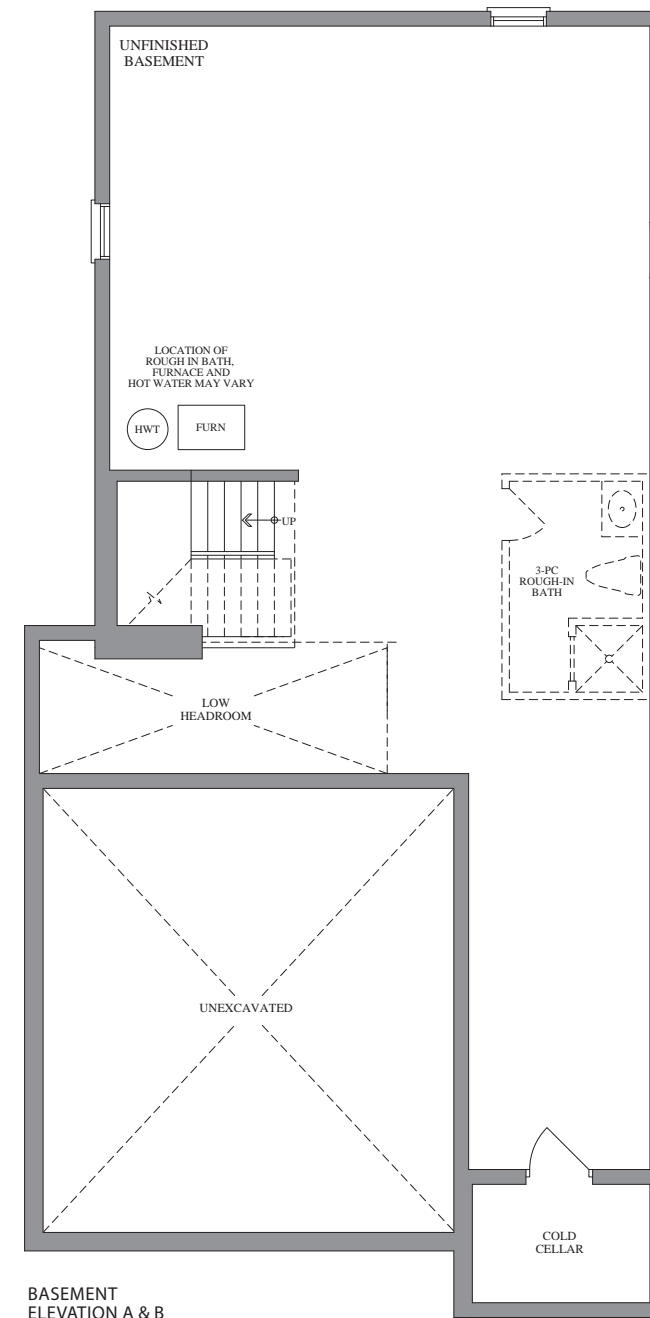

BASEMENT  
ELEVATION A & B

**From:** [Luana Casale](#)  
**To:** [Zachary De Meneghi](#)  
**Cc:** [Melanie Tan](#)  
**Subject:** Fwd: LOT 5-42, PH5, REVISED FINLAY FLOOR PLAN - LAUNDRY ROOM  
**Date:** Sunday, April 16, 2023 11:36:34 AM  
**Attachments:** [image005.png](#)  
[image006.png](#)  
[image007.png](#)  
[image008.png](#)  
[image005.png](#)  
[image006.png](#)  
[image007.png](#)  
[image008.png](#)

---

Lot 5-42 also agrees to move the door

Melanie please save the email into lormel shared

Sorry for any typos, sent from my iPhone

Begin forwarded message:

**From:** Iqbal Shahid <shahidim@rogers.com>  
**Date:** April 15, 2023 at 10:46:58 PM EDT  
**To:** Luana Casale <luana@lormelhomes.com>  
**Subject:** Re: LOT 5-42, PH5, REVISED FINLAY FLOOR PLAN - LAUNDRY ROOM

Hi Luana,

I accept your suggested change door location. shifting the door to the garage as suggested the attached drawing.

Iqbal S. Muhammad

On Thursday, April 13, 2023 at 05:25:07 p.m. EDT, Luana Casale <luana@lormelhomes.com> wrote:

Good afternoon, I hope this email finds you well.

Please see attachment to view a copy of your floorplan, specifically the laundry room

The plan has the door from the house to garage situated directly in front of the dryer. It seems however the spacing between the two may feel tight, especially when opening the dryer door and in the event the garage door opens.

Our construction team has suggested shifting the door to the garage as suggested the attached drawing. It's a good change and allows more space for dryer's door swing.

Please advise by email if you agree to make the switch to the suggested location or prefer to leave as per the original.

We need to my Monday April 17<sup>th</sup>. If we do not hear back from you, then we will proceed with the standard layout and no further change will be accommodated afterwards.

Regards,



**Luana Schiraldi**  
Sales, Marketing & Decor Manager

**The Design Studio**  
331 Cityview Blvd., Unit 3  
Vaughan, ON L4H 3M3  
Tel: (905) 832-3326 (Ext 503) Fax: (905) 832-3327  
[luana@LormelHomes.com](mailto:luana@LormelHomes.com)  
[www.LormelHomes.com](http://www.LormelHomes.com)



CONFIDENTIALITY NOTICE: This email message, including any attachments, is for the sole use of the intended recipient(s) and may contain confidential and privileged information. Any unauthorized review, use, disclosure or distribution is prohibited. If you are not the intended recipient, please reply to the sender by email and destroy all copies of the original message.