



SECOND FLOOR
ELEVATION A

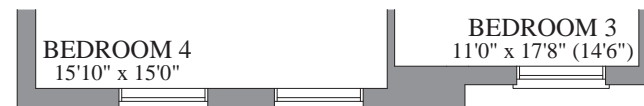

SECOND FLOOR
ELEVATION B

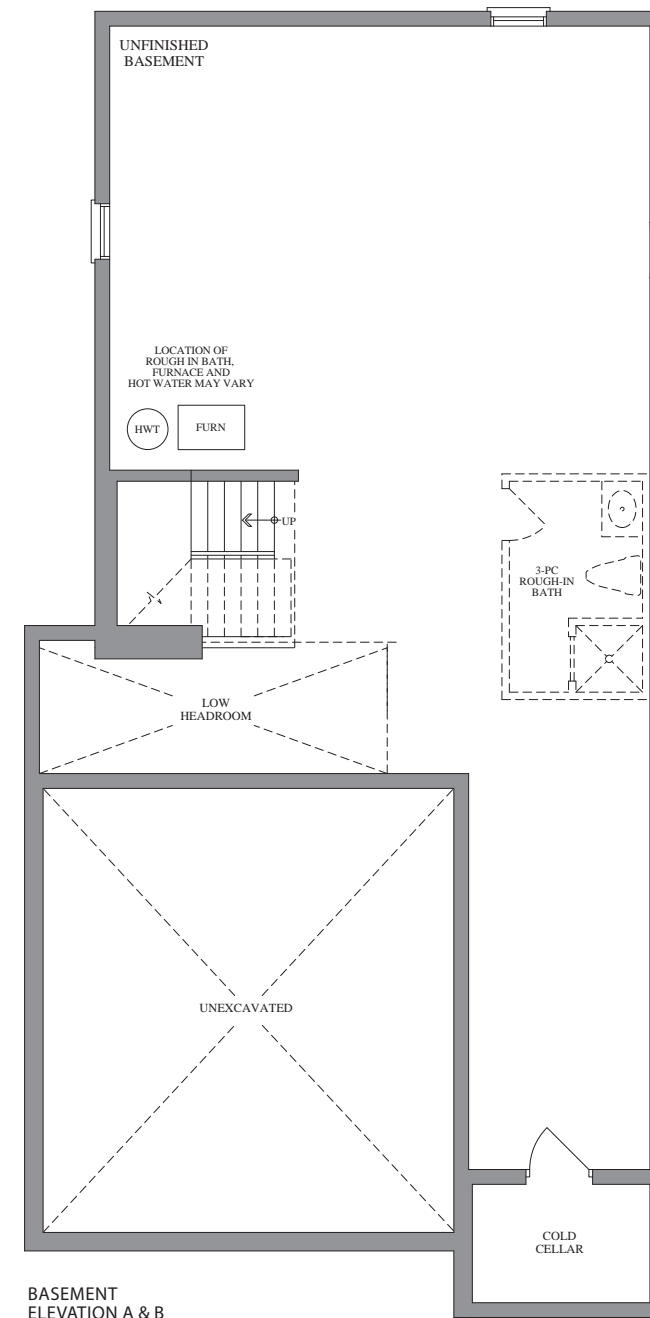

BASEMENT
ELEVATION A & B

From: [Luana Casale](#)
To: [Zachary De Meneghi](#)
Cc: [Melanie Tan](#)
Subject: Fwd: LOT 5-30, PH5, REVISED FINLAY FLOOR PLAN - LAUNDRY ROOM
Date: Sunday, April 16, 2023 11:37:31 AM
Attachments: [image005.png](#)
[image006.png](#)
[image007.png](#)
[image008.png](#)

Lot 5-30 agrees

Mel, please add to lormel shared
We need to look into request for cable

Sorry for any typos, sent from my iPhone

Begin forwarded message:

From: Mix Gallery with Qamar <ariazqamar@gmail.com>
Date: April 14, 2023 at 11:01:39 PM EDT
To: Luana Casale <luana@lormelhomes.com>
Subject: Re: LOT 5-30, PH5, REVISED FINLAY FLOOR PLAN - LAUNDRY ROOM

Hey we would like to go ahead with the suggested change.

I will also like to add a lan cable to the door bell area is that possible?

On Thu, Apr 13, 2023 at 5:26 PM Luana Casale <luana@lormelhomes.com> wrote:

Good afternoon, I hope this email finds you well.

Please see attachment to view a copy of your floorplan, specifically the laundry room

The plan has the door from the house to garage situated directly in front of the dryer. It seems however the spacing between the two may feel tight, especially when opening the dryer door and in the event the garage door opens.

Our construction team has suggested shifting the door to the garage as suggested the attached drawing. It's a good change and allows more space for dryer's door swing.

Please advise by email if you agree to make the switch to the suggested location or prefer to leave as per the original. We need to my Monday April 17th. If we do not hear back from you, then we will proceed with the standard layout and no further change will be accommodated afterwards.

Regards,



CELEBRATING
OVER 25 YEARS

Luana Schiraldi

Sales, Marketing & Decor Manager

The Design Studio

[331 Cityview Blvd., Unit 3](#)

[Vaughan, ON L4H 3M3](#)