


SECOND FLOOR  
ELEVATION A



SECOND FLOOR  
ELEVATION B

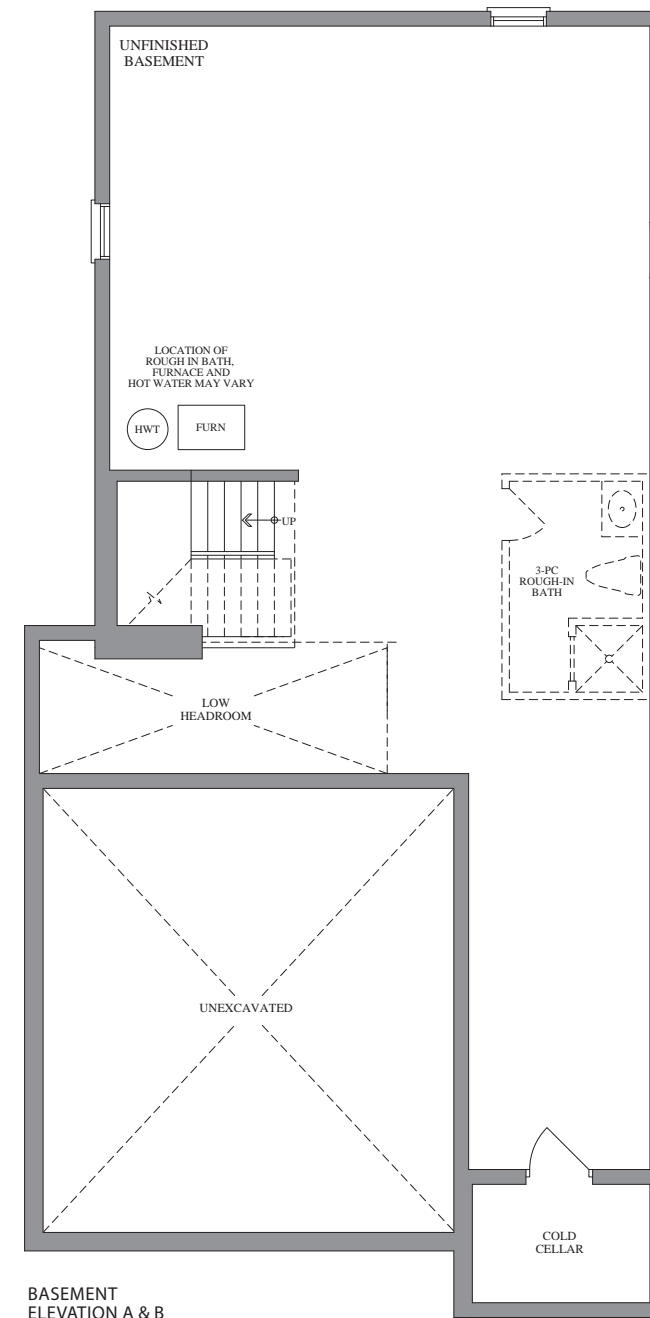

BASEMENT  
ELEVATION A & B

**From:** [Luana Casale](#)  
**To:** [Zachary De Meneghi](#)  
**Cc:** [Melanie Tan](#)  
**Subject:** Fwd: Recall: LOT 5-40, PH5, REVISED FINLAY FLOOR PLAN - LAUNDRY ROOM  
**Date:** Tuesday, April 18, 2023 11:01:05 AM

---

FYI. See below

Sorry for any typos, sent from my iPhone

Begin forwarded message:

**From:** Jaswant Thind <jaswantk45@yahoo.ca>  
**Date:** April 18, 2023 at 10:34:48 AM EDT  
**To:** Luana Casale <luana@lormelhomes.com>  
**Subject: Re: Recall: LOT 5-40, PH5, REVISED FINLAY FLOOR PLAN - LAUNDRY ROOM**

Hi Luana  
Pls do as they suggest for new location for door

Sent from my iPhone

On Apr 14, 2023, at 5:44 PM, Jaswant Thind  
<jaswantk45@yahoo.ca> wrote:

Hi Luana  
For Lot 40  
We can't open email properly. Please send it again.

Sent from my iPhone

On Apr 14, 2023, at 4:20 PM, narinder thind  
<thind22g@gmail.com> wrote:

Sent from my iPhone

Begin forwarded message:

**From:** narinder thind  
<thind22g@gmail.com>  
**Date:** April 14, 2023 at 8:18:52 AM EDT

**To:** Jaswant Thind <jaswantk45@yahoo.ca>  
**Subject: Fwd: Recall: LOT 5-40, PH5,  
REVISED FINLAY FLOOR PLAN -  
LAUNDRY ROOM**

Sent from my iPhone

Begin forwarded message:

**From:** Luana Casale  
<luana@lormelhomes.com>  
**Date:** April 13, 2023 at 5:27:00  
PM EDT  
**To:**  
Surinderdhaliwal780@yahoo.ca,  
harryhans81@gmail.com,  
thind22g@gmail.com  
**Subject: Recall: LOT 5-40,  
PH5, REVISED FINLAY  
FLOOR PLAN - LAUNDRY  
ROOM**

Luana Casale would like to  
recall the message, "LOT 5-40,  
PH5, REVISED FINLAY  
FLOOR PLAN - LAUNDRY  
ROOM".