
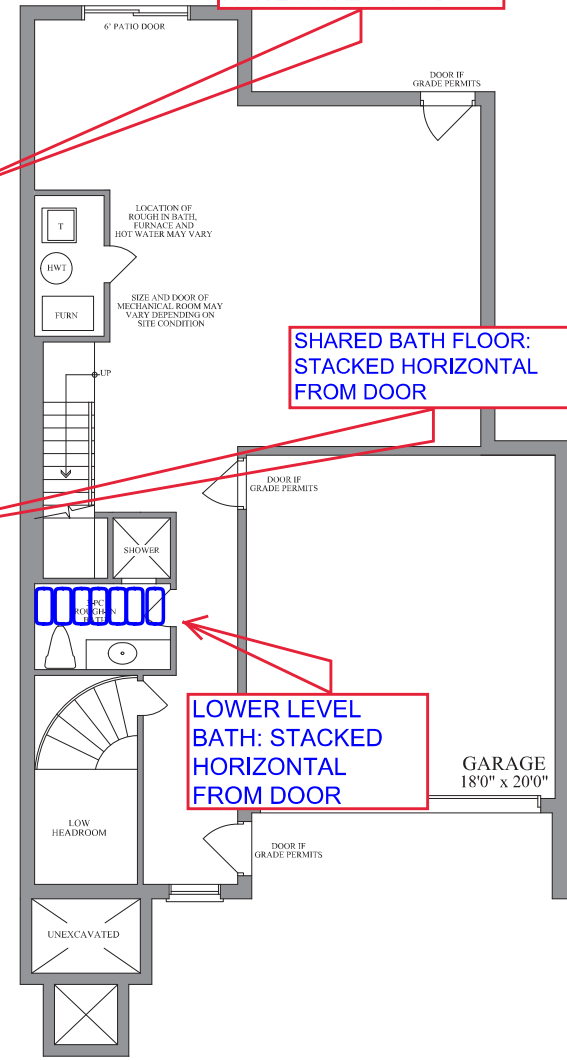
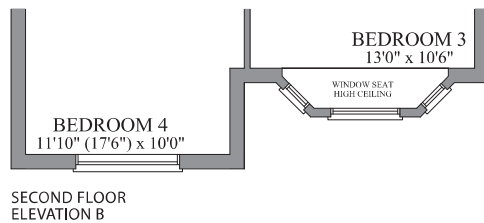
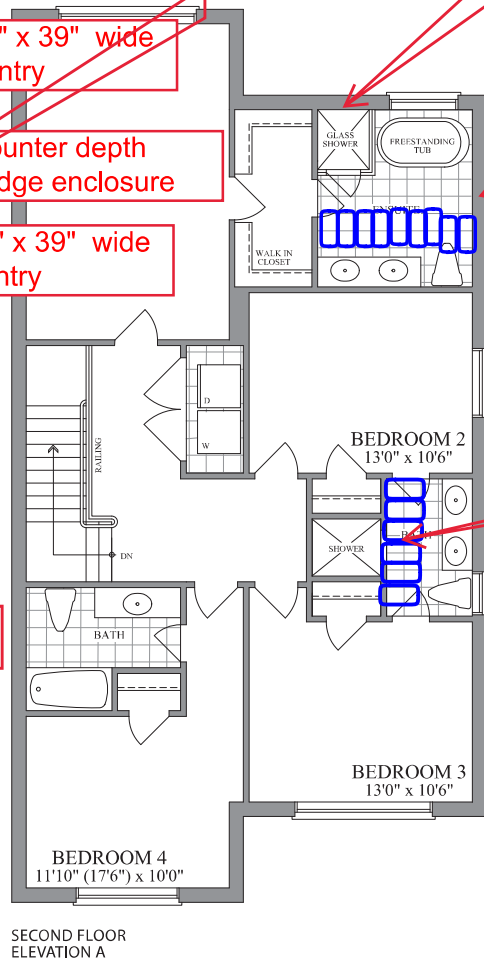


LOT 5-19, PH5, STRUCTURAL OPTIONS - PE002
PURCHASER: Can Mui Ho
Can Mui Ho (Jun 30, 2022 00:01 EDT)


RELOCATE STANDARD
CEILING LIGHTS FROM
KITCHEN/BREAKFAST
AREA TO ABOVE ISLAND -
LIGHTS TO BE APPROX.
4'FT APART & 30"INCHES
FROM END OF ISLAND

LOT 5-19, PH5, PE003 SKETCH
PRIMARY SHOWER
WALLS: TILES TO BE
STACKED FOLLOWING
DIRECTION OF FLOOR

Purchaser's Initial(s): Can Mui Ho
Can Mui Ho (May 1, 2023 15:46 EDT)
PRIMARY ENSUITE BATH
FLOOR: STACKED
HORIZONTAL FROM DOOR

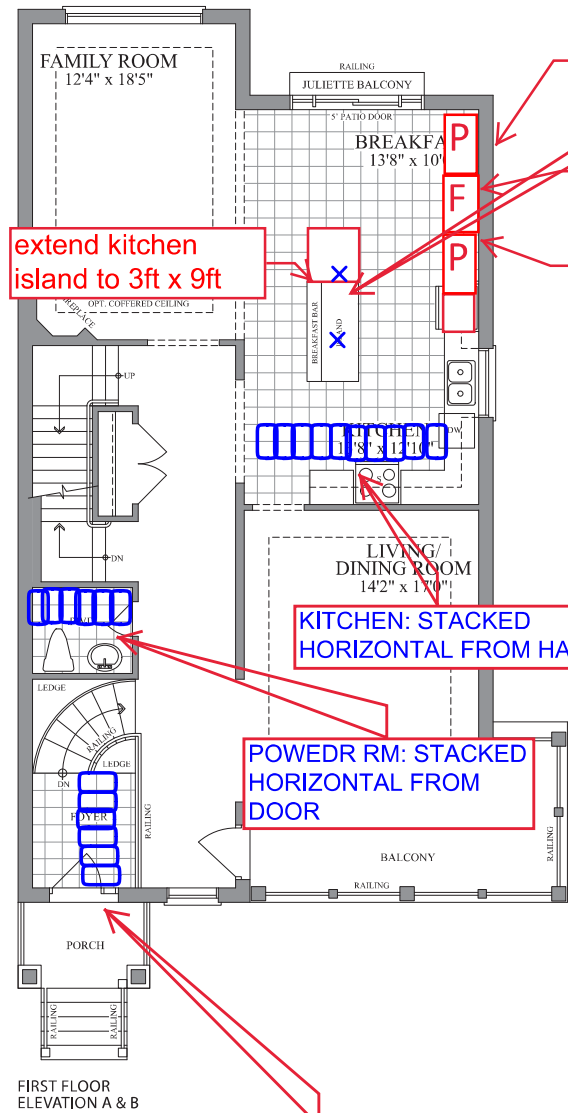

2 CAR GARAGE
3350 SQ. FT. INCLUDES 760 SQ. FT.
OF FINISHED AREA IN LOWER LEVEL

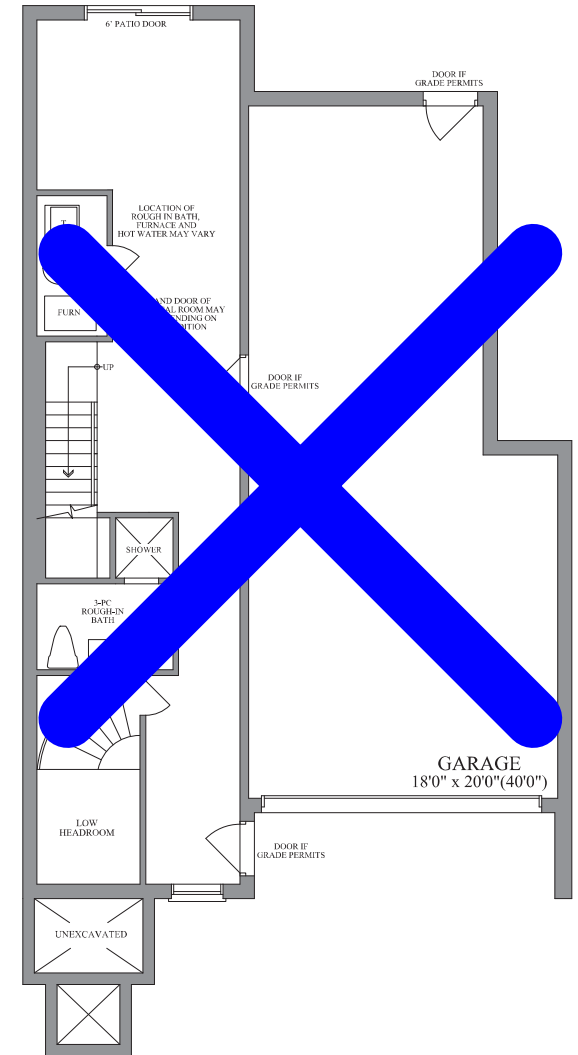

OPT. TANDEM 3 CAR GARAGE
3068 SQ. FT. INCLUDES 478 SQ. FT.
OF FINISHED AREA IN LOWER LEVEL