


LOT 5-27, PH5, PE003_A SKETCH

Purchaser's Initial(s): NS Jt

47'
DESIGNS

The hipissing / Elev. A & B
3210 sq.ft.



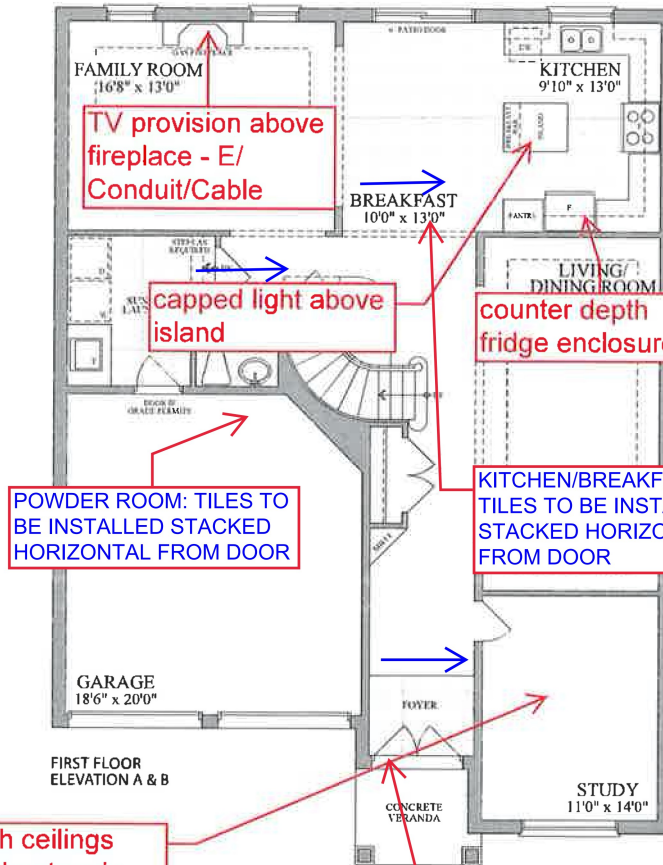


LOT 5-27, PH5, PE003_A

Purchaser: _____

Purchaser: Jaswantkthind
Jaswantkthind (May 3, 2022 23:34 EDT)

FOYER: TILES TO BE
INSTALLED STACKED
HORIZONTAL FROM DOOR

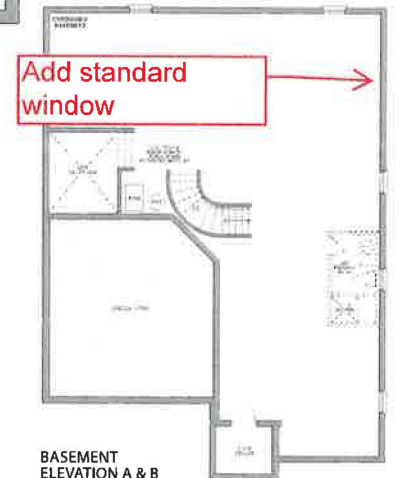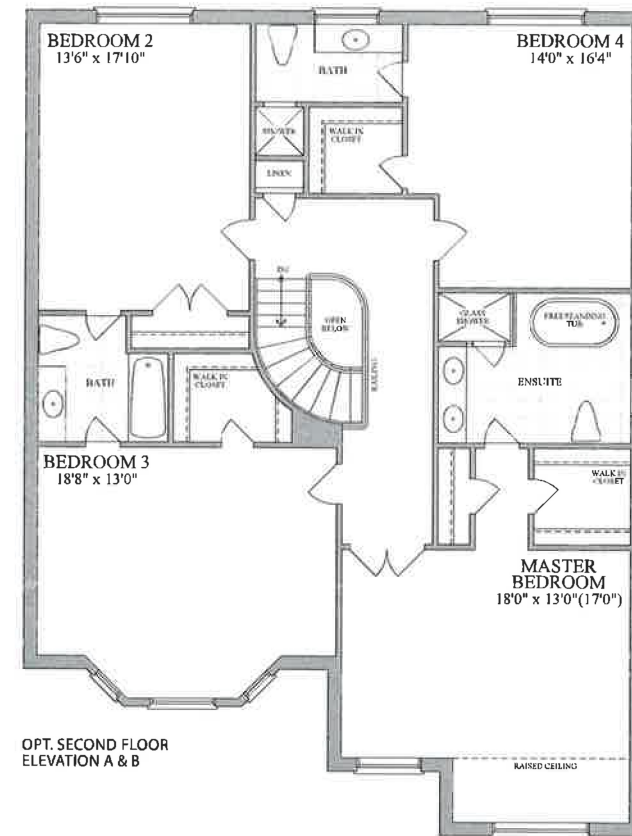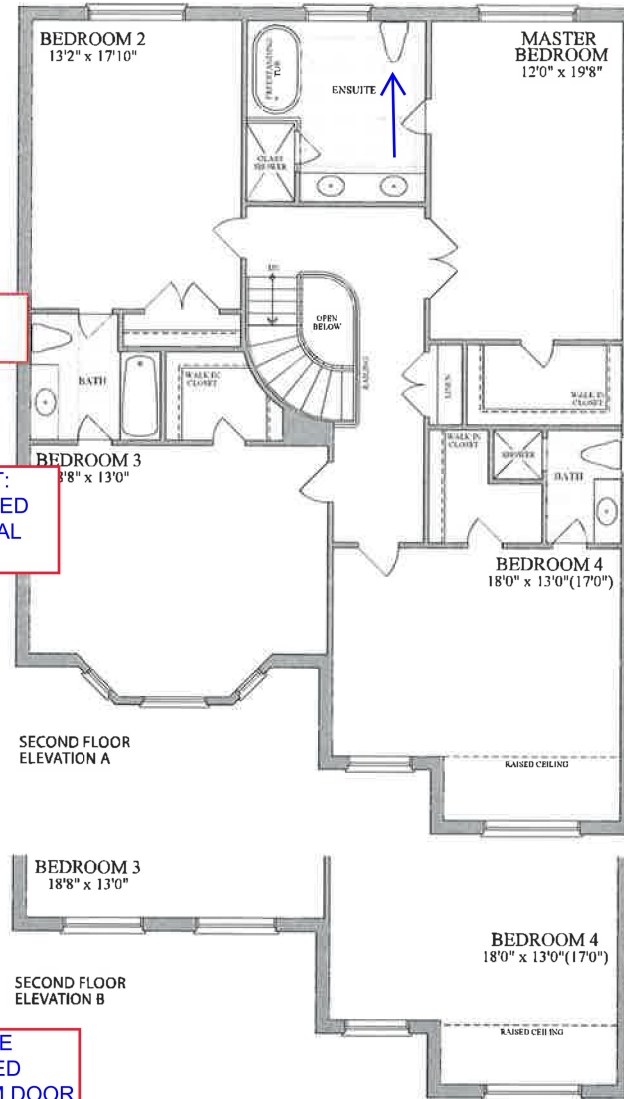

Plans and specifications are subject to change without notice. E. & O. E. Actual usable floor space may vary from the slated floor area. All renderings are artist's concept.