
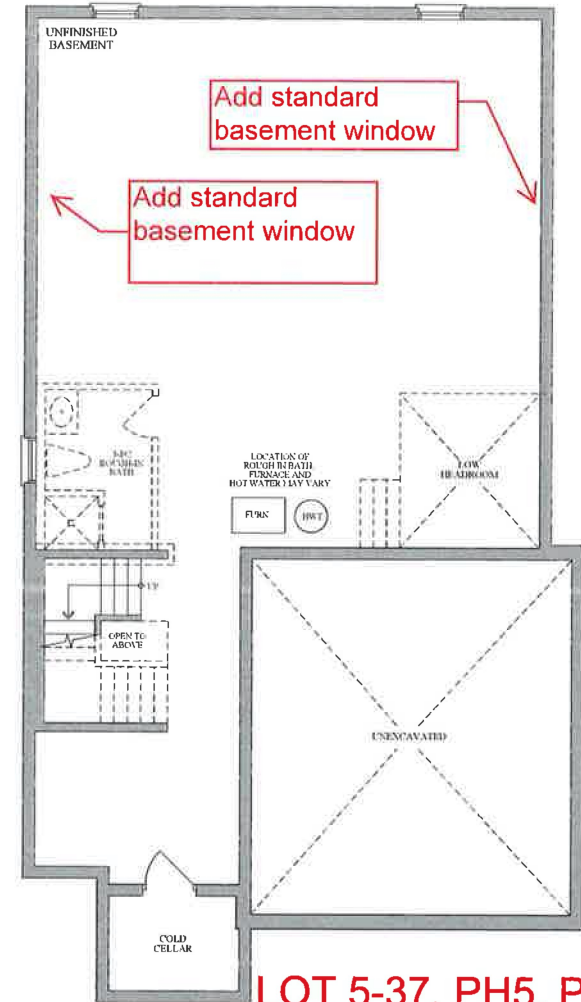


LOT 5-37, PH5, PE003, SKETCH

Purchaser's Initial(s): Jt ASB N.K.
Jt ASB NK

38'
DESIGNS

2480 sq.ft.
The Manitou / Elev. A & B

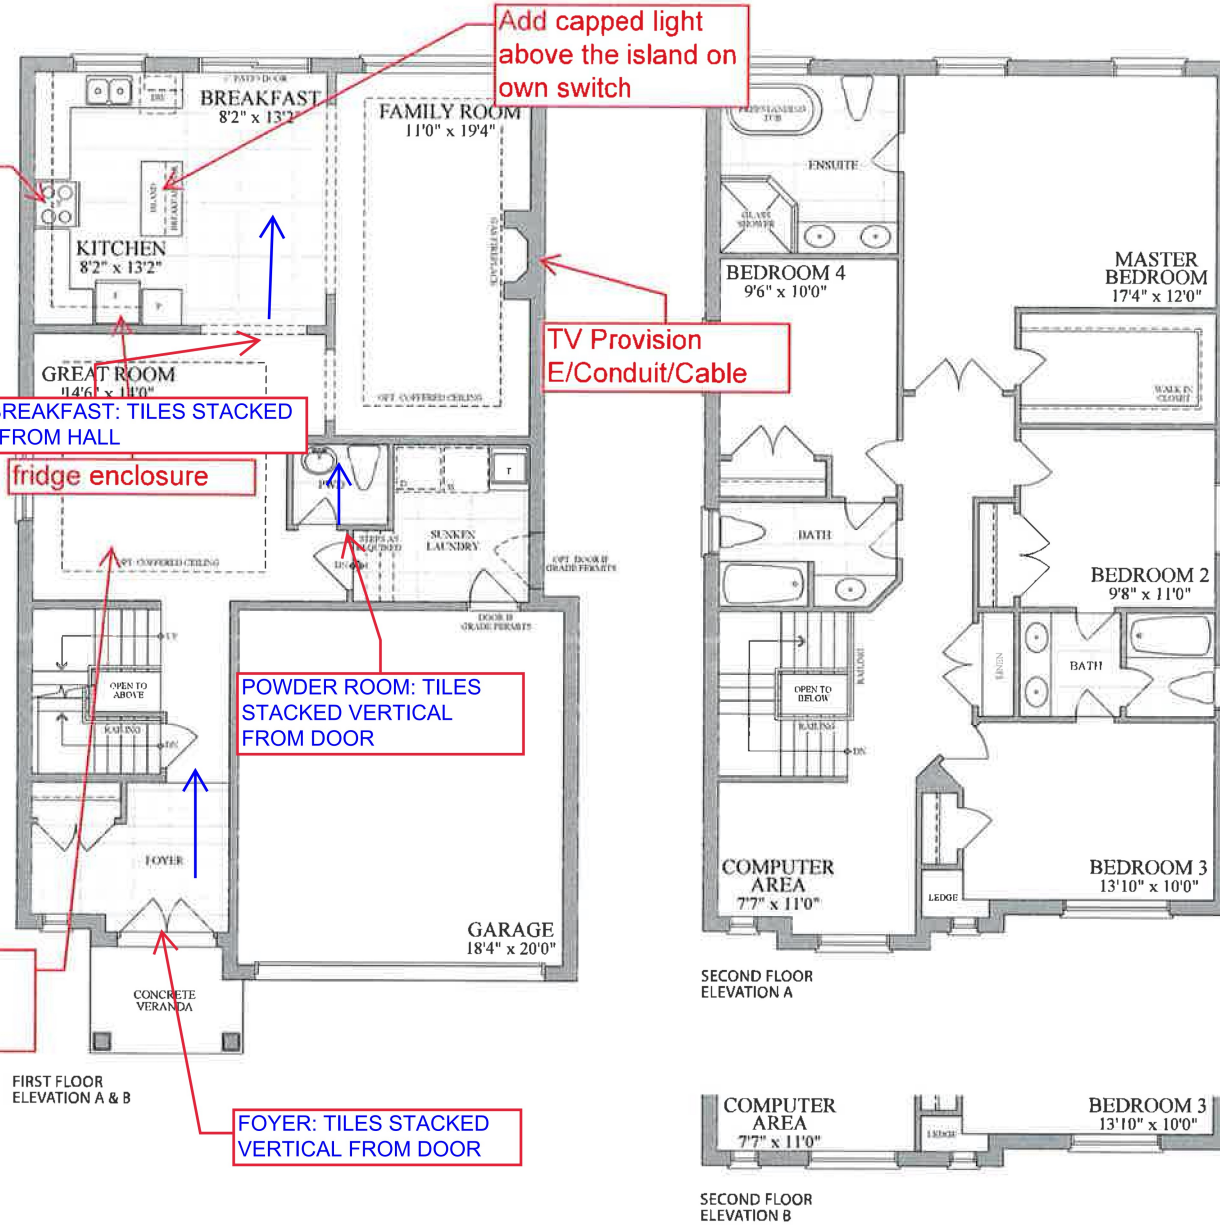

LOT 5-37, PH5, PE003, SKETCH

Purchaser: Jaswantkthind
 Jaswantkthind (May 17, 2022 14:49 EDT)

Purchaser: amarinder singh
 amarinder singh (May 18, 2022 19:55 EDT)

Navjot Kaur
 Navjot Kaur (May 16, 2022 15:41 EDT)



Plans and specifications are subject to change without notice. E. & O. E. Actual usable floor space may vary from the stated floor area. All renderings are artist's concept.