

LOT 5-41, PH5, PE004


Purchaser's Initial(s):

SB

38'
DESIGNS

provision for
chimney hood fan

Add capped light
above the island on
own switch

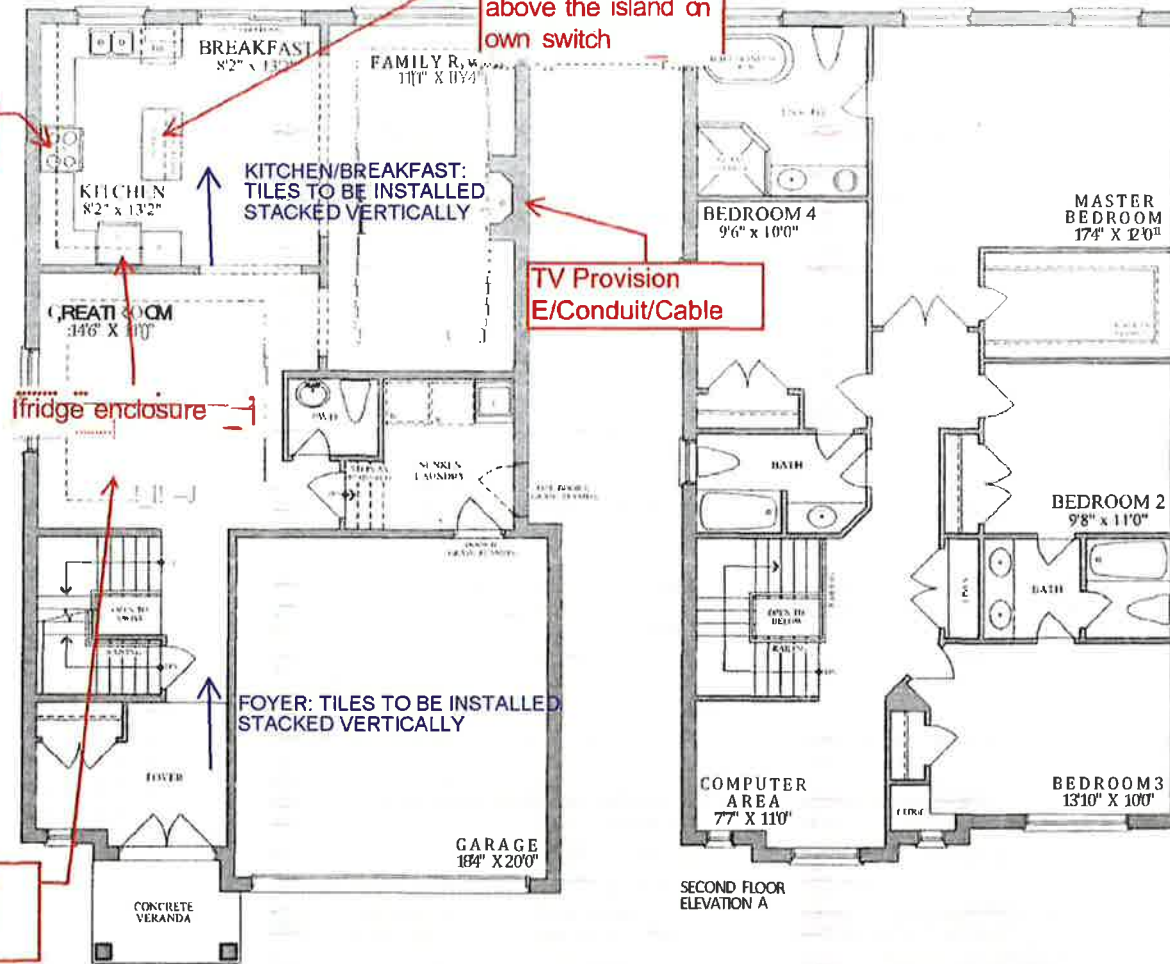


FIRST FLOOR
ELEVATION A & B

SECOND FLOOR
ELEVATION A

COMPUTER
AREA
7'7" x 11'0"

SECOND FLOOR
ELEVATION B

BEDROOM 3
13'10" x 10'0"

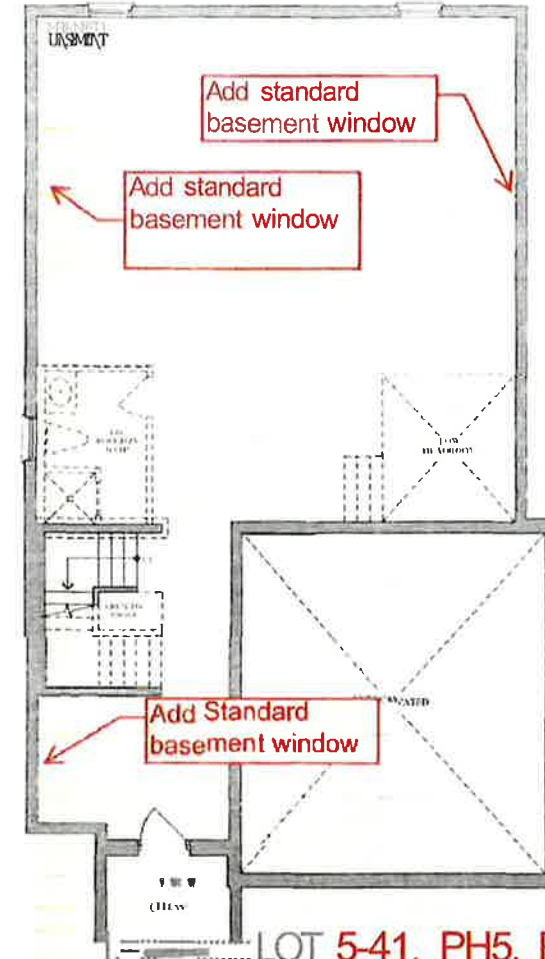

BASEMENT
ELEVATION A & B

LOT 5-41, PH5, PE002, SKETCH

Purchaser:

Sarbjitsandhu
Sarbjitsandhu (May 4, 2022 14:52 EDT)

Purchaser:

[Signature]