


LOT 5-15, PH5, CABLE LOCATIONS

Purchaser's Initial(s): DS

38'  
DESIGNS

The Superior / Elev. A & B  
3 Car Tandem 3400 sq.ft. - includes 530 sq. ft. of finished area in lower level  
2 Car Garage 3615 sq.ft. - includes 748 sq. ft. of finished area in lower level

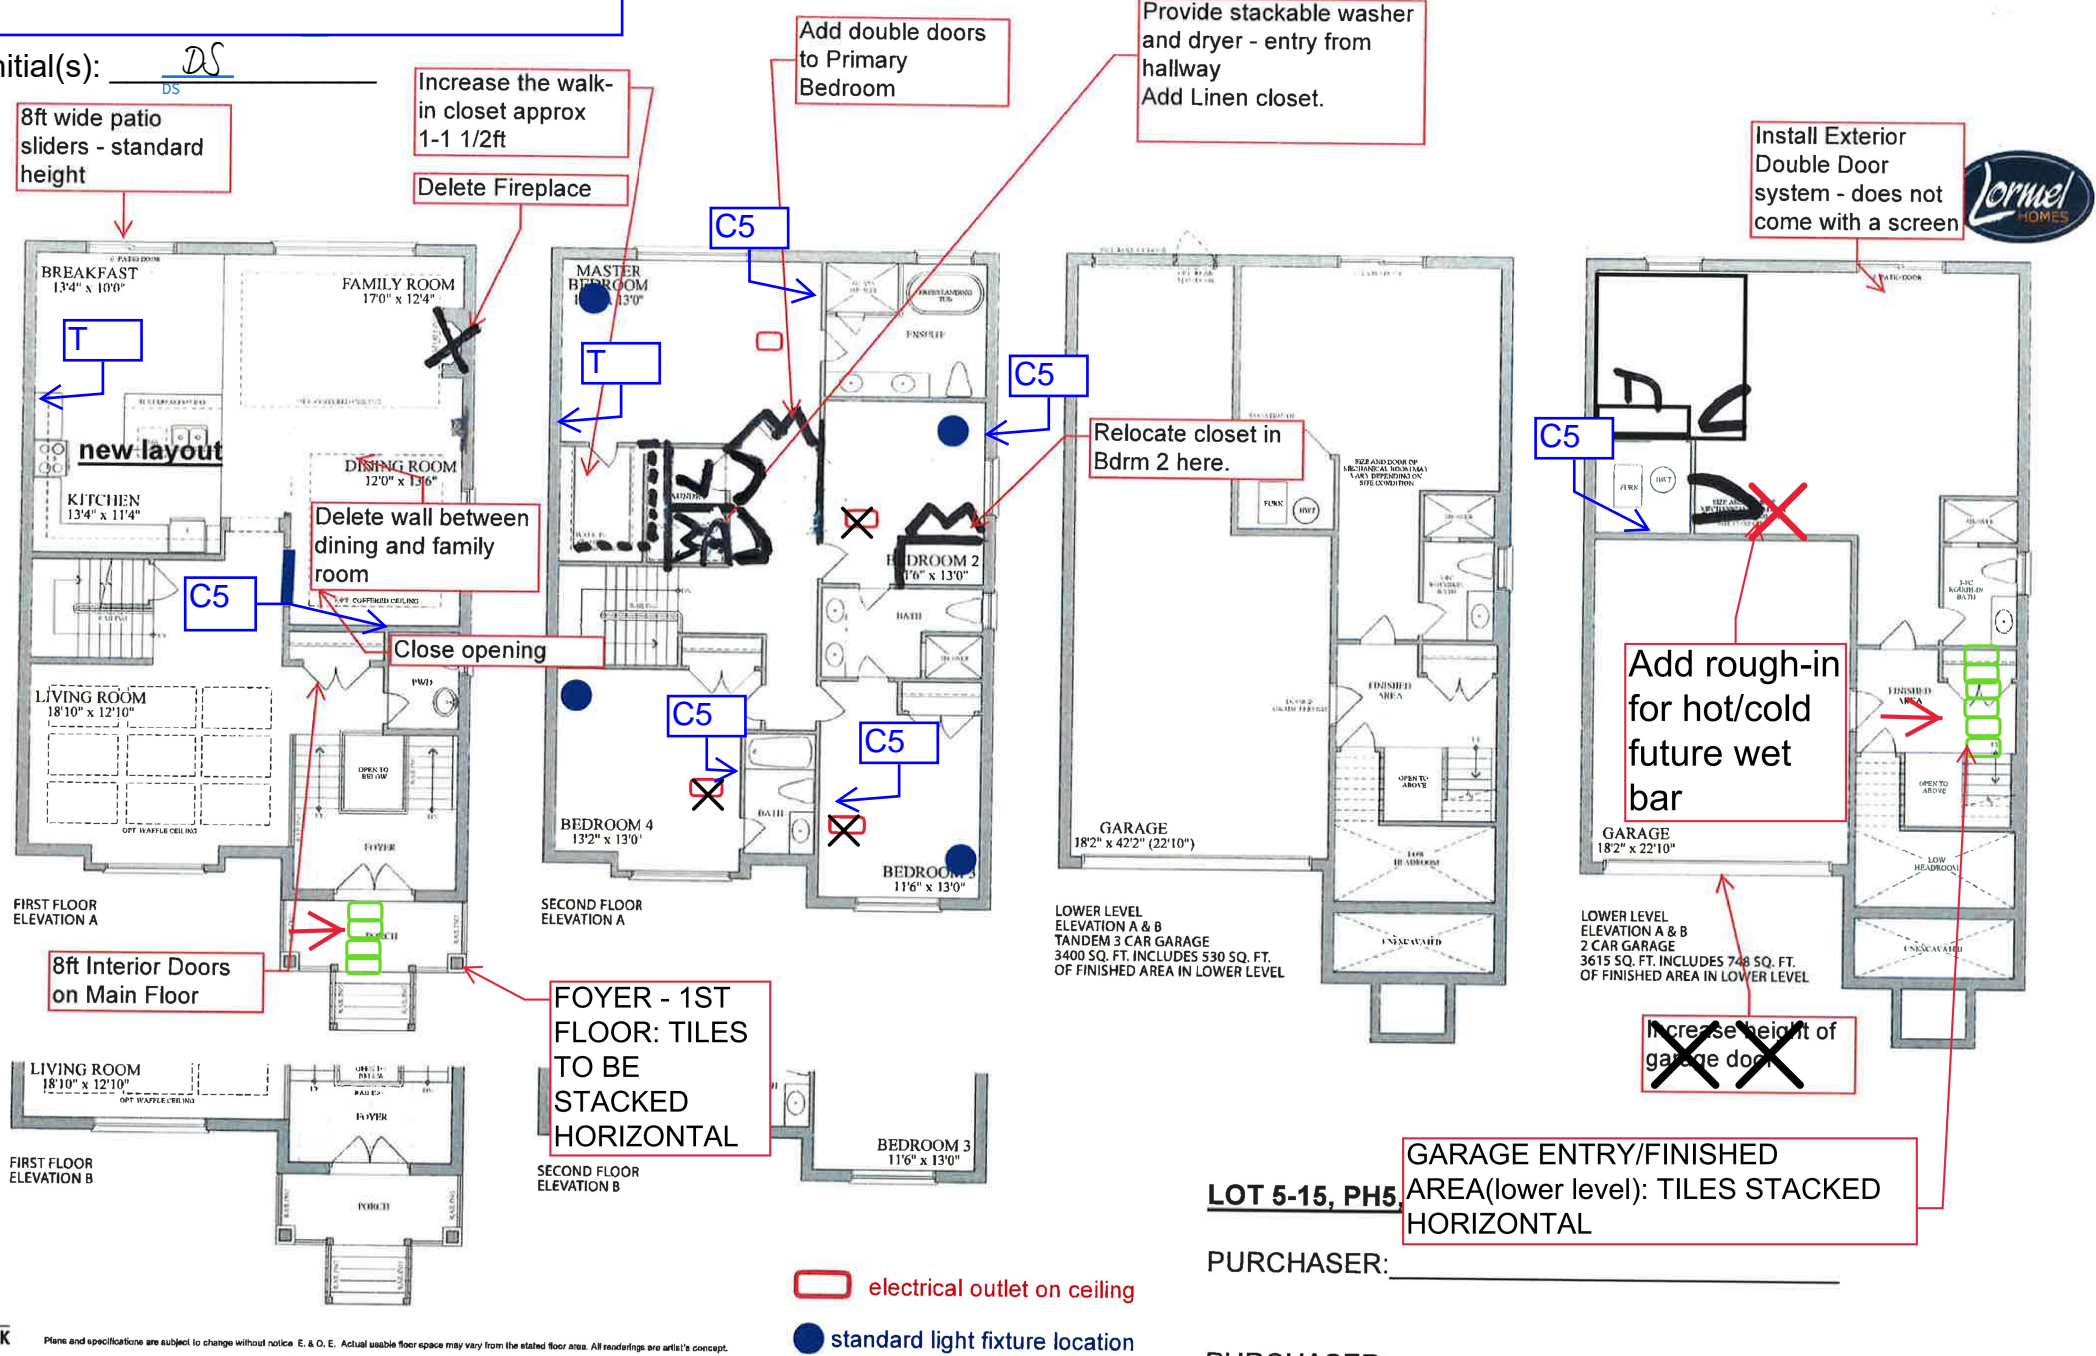

LOT 5-15, PH5  
PURCHASER: \_\_\_\_\_  
PURCHASER: \_\_\_\_\_

**Signature:** Dinesh Satrohan  
Dinesh Satrohan (Jul 25, 2023 15:34 EDT)

**Email:** dsatro@gmail.com